

MISSISSIPPI DEPARTMENT OF NATURAL RESOURCES

Bureau of Land and Water Resources

Southport Mall

P.O. Box 10631

Jackson, Mississippi 39209

WATER WELL DRILLERS LOG

Madison
P2001

Dec. 14 1983 E.M. "Bud" Cresswell Madison
date well completed firm name county well located

LANDOWNER:	description of formations encountered	from	to
<u>Alligator Hunting Club</u>			
<u>Jackson, Ms.</u> (mailing address)	<u>Clay</u> <u>sand</u>	<u>0</u> <u>5</u>	<u>5</u> <u>35</u>
WELL LOCATION:			
sec. <u>22</u> T <u>9</u> N R <u>5</u> E <u>14</u> miles <u>EAST</u> of <u>CANTON</u> (distance) (direction) (nearest town)			
WELL PURPOSE: <u>None</u> (home, irrigation, municipal, industrial)			
WELL COMPLETION DATA:			
(1) diameter (inches) <u>2</u>			
(2) total depth (feet) <u>35</u>			
(3) static water level (feet) <u>10</u> below top of ground.			
(4) casing <u>PVC</u> <u>25</u> (material) (depth)			
<u>2</u> (size) If telescope see back.			
(5) screen <u>10</u> <u>25</u> (length) (depth to top)			
<u>2</u> <u>PVC</u> (size) (material)			
(6) pump <u>1/2</u> <u>10</u> (HP) (yield gpm)			
(type power)			
(7) electric log <u>no</u> (yes or no)			
(organization running log)			
(8) <u>no</u> well bottom plugged <u>back wash</u>			
DRILLERS REMARKS:			


DEPT. OF NATURAL RESOURCES
BUREAU OF LAND & WATER RESOURCES

JAN 5 - 1984

RECEIVE

If well telescopes please sketch and show depths.

GROUND LEVEL

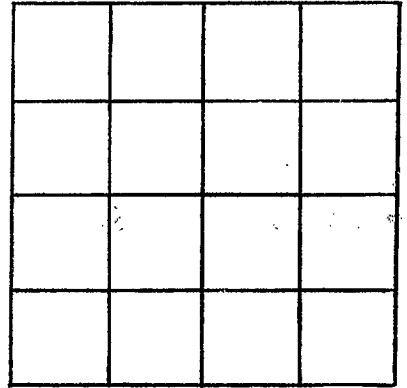

SECTION _____

Please indicate well location X.

ADDITIONAL INFORMATION

If more than one screen,
show locations of each on sketch.