

MISSISSIPPI DEPARTMENT OF NATURAL RESOURCES

Bureau of Land and Water Resources

Southport Mall

P.O. Box 10631

Jackson, Mississippi 39209

WATER WELL DRILLERS LOG

MADISON
P
2007

1-6 1986 date well completed
THOMAS + SON firm name
Madison CO county well located

LANDOWNER: Robert Paul Harris

Rt 2

CARTHAGE MS
(mailing address)

description of formations encountered

Red Dirt
Grey Chalk
White sand

from	to
0	10
10	35
35	103

WELL LOCATION:

sec. 13 T 10 N R 8 E S 5
3 miles NE of Farm Haven
(distance) (direction) (nearest town)

Deep 103

WELL PURPOSE:

(home, irrigation, municipal, industrial)

WELL COMPLETION DATA:

- (1) diameter (inches) 2"
- (2) total depth (feet) 103'
- (3) static water level (feet) 22' below top of ground
- (4) casing PVC, 103' (material) (depth)
2" (size) If telescope see back.
- (5) screen 10' 93' (length) (depth to top)
2" (size) PVC (material)
- (6) pump 1 (HP) 8 (yield gpm)
Electric (type power)
- (7) electric log NO (yes or no)

(organization running log)

(8) how well bottom plugged Stone

RECEIVED


JAN 17 1986

Department of Natural Resources
Bureau of Land & Water Resources

DRILLERS REMARKS:

If well telescopes please sketch and show depths.

GROUND LEVEL

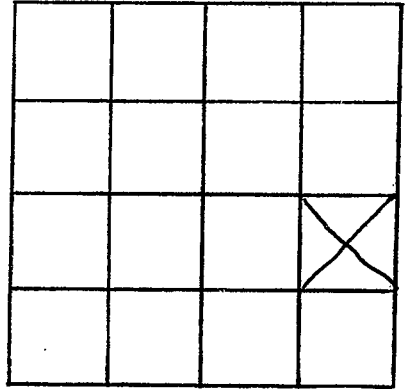

SECTION _____

Please indicate well location X.

ADDITIONAL INFORMATION

If more than one screen, show locations of each on sketch.