

MISSISSIPPI DEPARTMENT OF NATURAL RESOURCES

Bureau of Land and Water Resources

Southport Mall

P.O. Box 10631

Jackson, Mississippi 39209

WATER WELL DRILLERS LOG

MADISON
P 2003

Town 11 1986 E.M. Bud Cresswell Madison  
 date well completed firm name county well located

LANDOWNER:  
 LEE HAWKINS  
 Madison, Ms.  
 (mailing address)

description of formations encountered	from	to
SURFACE	0	5
SAND	5	30

WELL LOCATION:  
 sec. 2 T 9 N R 5 E  
 S  
 10 miles EAST of CANTON  
 (distance) (direction) (nearest town)

WELL PURPOSE: C&D  
 (home, irrigation, municipal, industrial)

WELL COMPLETION DATA:

(1) diameter (inches) 4

(2) total depth (feet) 30

(3) static water level (feet) 3 below top of ground.

(4) casing PVC 20 (material) (depth)  
 4 (size) if telescope see back.

(5) screen 10 20 (length) (depth to top)  
 4 PVC (size) (material)

(6) pump 1 20 (HP) (yield gpm)

(type power)

(7) electric log No (yes or no)

(organization running log)

(8) how well bottom plugged BACK WASH


RECEIVED  
 JUN 25 1986

Department of Natural Resources  
 Bureau of Land & Water Resources

DRILLERS REMARKS:

If well telescopes please sketch and show depths.

GROUND LEVEL

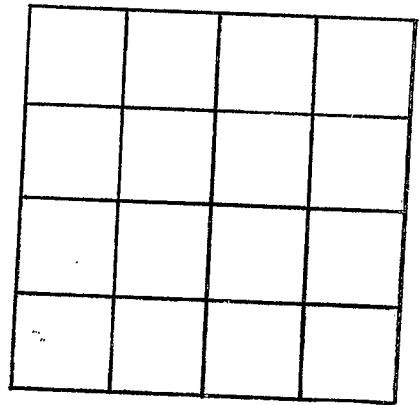

SECTION \_\_\_\_\_

Please indicate well location X.

ADDITIONAL INFORMATION

Lined area for additional information, consisting of approximately 25 horizontal lines.

If more than one screen, show locations of each on sketch.