

MADISON WATER WELL DRILLERS LOG

Q
5-15-62

McKany

Hin

Date: May 15, 1962, Driller: D H Williams

County: ~~Madison~~

(Name)

- (1) Owner of Land: E H Cox
(Name)

(Address)
- (2) Location: 13 1/4, NW 1/4, Sec. 13 T. R.
Near Cox's Ferry
5 miles N. with, of Brownville
(distance) (direction) (Nearest Town)
- (3) Topography: ✓
(Hilly) (Flat) (Level)
- (4) Purpose of Well: Home + Farm
(Domestic Irrigation
Municipal, Industrial, Other)

Description & Color of Materials Sand, Clay, Red Clay, Shell, etc.	Thick- ness Feet	Depth Feet
<u>1 to 24 Red Clay</u>	<u>24</u>	<u>24</u>
<u>24 to 34 Red Clay Shale</u>	<u>10</u>	<u>34</u>
<u>34 to 38' Clay Shale</u>	<u>4</u>	<u>38</u>
<u>38 to 44 Sandy</u>	<u>6</u>	<u>44</u>
<u>44 to 54 Sand + Shale</u>	<u>10</u>	<u>54</u>
<u>54 to 84 All Sand</u>	<u>30</u>	<u>84</u>


Information upon completion of well:

- (1) Diameter 4 inches.
- (2) Total Depth 94 feet.
- (3) Water Level 30 feet below top of ground.
- (4) Cased to 70ft, Size 2"
- (5) Screen: Size 2", Length 15ft.
- (6) Were any formations sealed against pollution?
✓ yes, no.

If YES depth of formation 10ft

Why Keep Back Surface Pollution

Drillers Remarks:

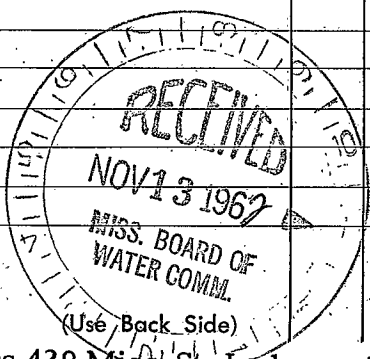

Well No.

