

CODED

CODED

MISSISSIPPI
 BOARD OF WATER COMMISSIONERS
 416 North State Street
 Jackson, Mississippi 39201

WATER WELL DRILLERS LOG

Madison
Q 16
9-30-68

9--30 1968 Bud Cresswell Madison
 date well completed firm name county well located

LANDOWNER:
 Jimmy Cox
 Jackson, Miss.
 (mailing address)


description of fomations encountered	from	to
clay yellow	0	25
Blue clay	25	550
sand coarse	550	640

WELL LOCATION:
 sec 27 T 8 N R 2 E ^{OK} _{20R}
5 miles SW of Flora
 (distance) (direction) (nearest town)

WELL PURPOSE: domestic
 (home, irrigation, municipal, industrial)

- WELL COMPLETION DATA:
- (1) diameter (inches) 4 x 2
640
 - (2) total depth (feet) 640
 - (3) static water level (feet) 85 below above top of ground.
 - (4) casing black pipe,
 (material) (depth)
4" If telescope see back.
 (size)
 - (5) screen 20, 620
 (length) (depth to top)
008, stainless
 (size) (material)
 - (6) pump _____
 (HP) (yield gpm)
 (type power)
 - (7) electric log _____
 (yes or no)
 (organization running log)
 - (8) how well bottom plugged _____


CODED

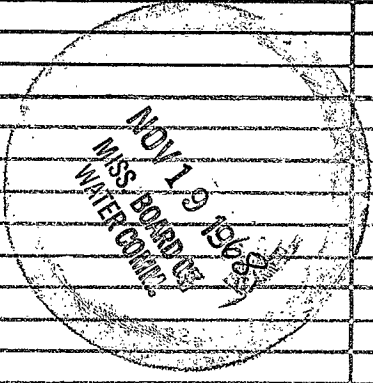

DRILLERS REMARKS:

If well telescopes please sketch and show depths.

GROUND LEVEL

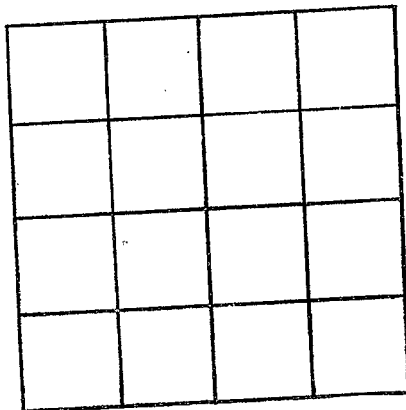

SECTION _____

Please indicate well location X.

ADDITIONAL INFORMATION

If more than one screen, show locations of each on sketch.