

MADISON

WATER WELL DRILLERS LOG

CODED

Q 18

8-21-62

Date: Aug 21, 1962, Driller: M^{rs} Kay Dally County: Madison

(Name)

(1) Owner of Land: E. Ritchison
(Name)
Flora
(Address)

(2) Location: 1/4, 1/4, Sec. 12 T8 R2W
4 miles West of Flora
(distance) (direction) (Nearest Town)

(3) Topography: (Hilly) (Flat) (Level)

(4) Purpose of Well: Home
(Domestic Irrigation
Municipal, Industrial, Other)

Description & Color of Materials Sand, Clay, Red Clay, Shell, etc.	Thick- ness Feet	Depth Feet
yellow clay	0	31
yellow clay	2.7	30
Blue clay	30	42
" "	43	63
" "	63	84
" "	84	105
" "	105	126
Blue Clay	156	357
Shed clay	357	378
Sand clay	378	399
Sandy Clay	399	504
Fine Sand	504	630
Med Sand	630	672

Information upon completion of well:

(1) Diameter 4 X 2 inches.

(2) Total Depth 672 feet.

(3) Water Level 90 feet below top of ground.


(4) Cased to 315, Size 4"

(5) Screen: Size 006, Length 30ft

(6) Were any formations sealed against pollution?
no.

2 HP Jet Pump
2 Stage 1 1/4 X 1
82 gal/min

CODED

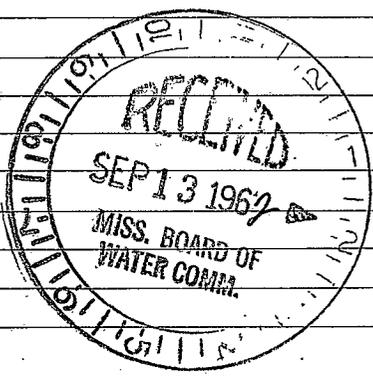

If YES depth of formation _____

Why _____

Drillers Remarks: _____

(Use Back Side)

Well No.

