

**RQ19**  
12-6-62

**WATER WELL DRILLERS LOG**

**CODED**

*Forest Drilling*

Date 11/29 to 12/6 1962, Driller: Johnnie Beasley County Madison  
(Name)


	Description & Color of Materials Sand, Clay, Red Clay, Shell, etc.	Thick- ness Feet	Depth Feet
(1) Owner of Land: <u>Mrs. J. O. Rankin</u> (Name) <u>Rt. #1, Flora, Miss.</u>	Yellow clay.	54-	54
Go to Flora and take 22 Hwy. and	Blue cla.	156-	210
(2) Location: <u>1/4, 1/4, Sec. 26 T8R24</u>	Hard blue shale.	340-	550
go until you cross third bridge	Shale & lime.	95-	645
then turn on first right, hand Rd.	Silt sand & shale.	27-	672
(3) Topography: <u>X</u> (Hilly) (Flat) (Level)	Shale & lignite.	9-	681
(4) Purpose of Well: <u>Domestic.</u> (Domestic Irrigation Municipal, Industrial, Other)	Soft shale.	20-	701
	Soft shale & stks. sand.	73-	774
	Fine sand.	26-	800
	Sand. (Screen setting.)	29-	829

Information upon completion of well:

- (1) Diameter 2 inches.
- (2) Total Depth 829 feet.
- (3) Water Level 130 feet below top of ground.
- (4) Cased to 819', Size 2"
- (5) Screen: Size 2", Length 10'
- (6) Were any formations sealed against pollution?  
\_\_\_\_\_ yes, X no.

**CODED**

If YES depth of formation \_\_\_\_\_  
Why \_\_\_\_\_  
Drillers Remarks: Good well.

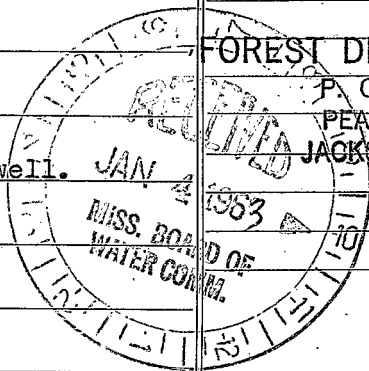

**FOREST DRILLING SERVICE**  
P. O. Box 5717  
PEARL BRANCH  
JACKSON 8, MISS.

(Use Back Side)

Well No.

