

Madison Co
 Q 20
 7-69

MISSISSIPPI
 BOARD OF WATER COMMISSIONERS
 416 North State Street
 Jackson, Mississippi 39201

CODED

WATER WELL DRILLERS LOG

7-20 1969 Bud Cresswell Madison
 date well completed firm name county well located

LANDOWNER:
 Madison County Livestock
 Inc. , Flora, Miss.
 (mailing address)

description of formations encountered	from	to
clay	0	60
Blue clay	60	530
sand sea shells	530	560
shale	560	590
sand	590	640
shale	640	680
sand	680	740

WELL LOCATION:
 sec. 12 T 8 R 2
 2 miles west of Flora
 (distance) (direction) (nearest town)

WELL PURPOSE: STOCK
 (home, irrigation, municipal, industrial)

WELL COMPLETION DATA:
 (1) diameter (inches) 4 x 2
 (2) total depth (feet) 740
 (3) static water level (feet) 130 below top of ground.
 (4) casing Blk. 294
 (material) (depth)
 4" If telescope see back.
 (size)
 (5) screen 20 720
 (length) (depth to top)
 008 stainless
 (size) (material)
 (6) pump (HP) (yield gpm)
 (type power)
 (7) electric log (yes or no)
 (organization running log)
 (8) how well bottom plugged

DRILLERS REMARKS:


APR 5 1969

MISS. Bd. OF
 WATER COMMISSIONERS

MISSISSIPPI
BOARD OF WATER COMMISSIONERS
 410 North State Street
 Jackson, Mississippi 39201
WATER BILT FILTER LOG

If well telescopes, please sketch and show depths.

GROUND LEVEL

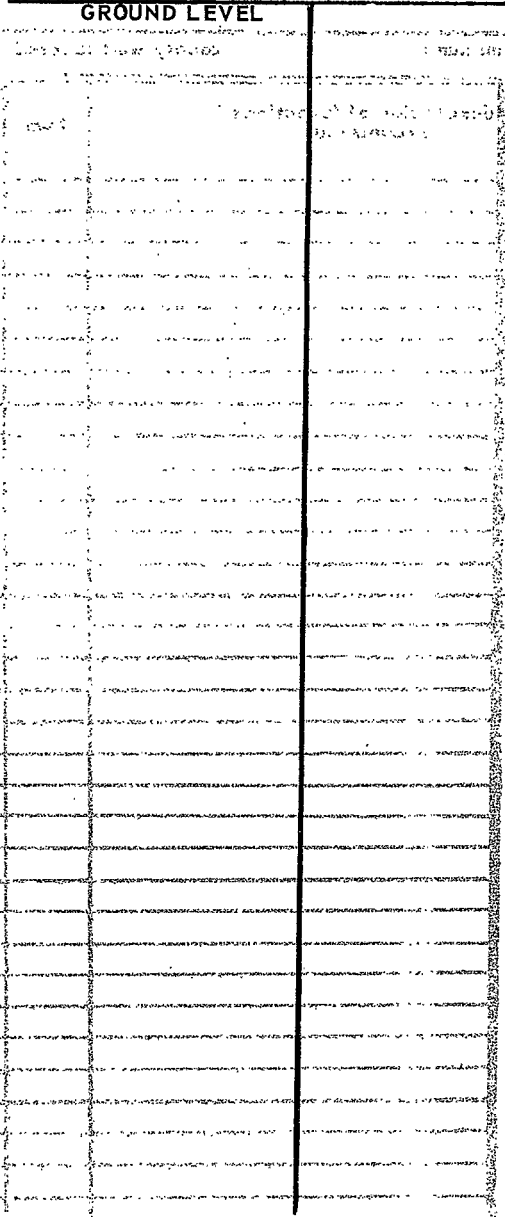

If more than one screen, show locations of each on sketch.

SECTION

Please indicate well location X

ADDITIONAL INFORMATION

(test) (depth) (ft) (S)

(flow) (level) (arrow) (ft) (S)

showing to get

(depth) (lat/long) (ft) (S)

(axis)

(ft) (S)

(pot of depth) (diesel) (ft) (S)

(line) (axis) (ft) (S)

(use) (width) (ft) (S)

(solar) (ft) (S)

(ft) (S)

(ft) (S)

(ft) (S)

(ft) (S)