

MADISON

Q 21

10-26-70

MISSISSIPPI
BOARD OF WATER COMMISSIONERS
416 North State Street
Jackson, Mississippi 39201

CODED

WATER WELL DRILLERS LOG

10-26-70, James McNeess

Madison

date well completed

firm name

county well located

LANDOWNER: Kendall QUINN

Box 1152

JACKSON MISS

(mailing address)

WELL LOCATION:

sec. 9 T. 8 N. R. 2 E
5 W
10 miles West of Flora
 (distance) (direction) (nearest town)

WELL PURPOSE: Farm
 (home, irrigation, municipal, industrial)

WELL COMPLETION DATA:

- (1) diameter (inches) 4" x 2 1/2"
- (2) total depth (feet) 692
- (3) static water level (feet) 53 below top of ground.
- (4) casing steel 639
 (material) (depth)

(size) If telescope see back.

- (5) screen 20 639
 (length) (depth to top)
2 1/2 stainless steel
 (size) (material)

- (6) pump 5 50
 (HP) (yield gpm)
Elec
 (type power)

- (7) electric log yes
 (yes or no)
M.G.S.
 (organization running log)

- (8) how well bottom plugged
Back Wash Valve

description of formations encountered	from	to
SURFACE SOIL	0	5
CLAY	5	25
SAND	25	60
Grey shale	60	508
ROCK	508	509
Grey sdy sh	509	520
Grey sh sd strk	520	551
SAND	551	560
SAND-sh-strk	560	595
SAND	595	681
Grey shale	681	692

16 fts 4"	338	
4" x 2 1/2 SWEDGE	1	
14 fts 2 1/2"	339	
	300	
	639	
2 1/2" .008-sh screen	21	
	660	

CODED


NOV 5 1970
MISS. Bd. OF WATER COM.

DRILLERS REMARKS:

Water does not have color

If well telescopes please sketch and show depths.

GROUND LEVEL

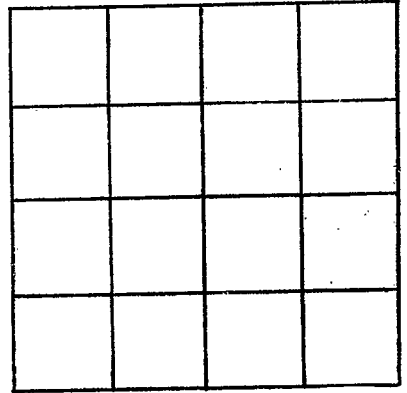

SECTION _____

Please indicate well location X.

ADDITIONAL INFORMATION

If more than one screen,
show locations of each on sketch.