

MADISON

Q 22

WELL DRILLERS LOG

CODED

Date: 7-28-63 19 67 Driller: CREEK (Name) MISSWELL County: MADISON


(1) Owner of Land: T. M. Donnell (Name)
 1-609A (Address)
 (2) Location: 1/4, 1/4, Sec. 20 T8 R2W
 miles (distance) West of (direction) of (Nearest Town)
 (3) Topography: (Hilly) (Flat) (Level)
 (4) Purpose of Well: Domestic Irrigation (Municipal, Industrial, Other)

Description & Color of Materials Sand, Clay, Red Clay, Shell, etc.	Thick- ness Feet	Depth Feet
FOREST Hill		
1600 BURN VAD.	160	160
11500 CLAY	40	200
INDUST. GRAVEL	30	230
GREY SAND	40	270
		310
		350
		390
Information upon completion of well:

(1) Diameter 4 1/2 inches.
 (2) Total Depth 820 feet.
 (3) Water Level 175 feet below top of ground.
 (4) Cased to 800, Size 2 1/2"
 (5) Screen: Size 2", Length 20"
 (6) Were any formations sealed against pollution?
 _____ yes, _____ no.

CODED

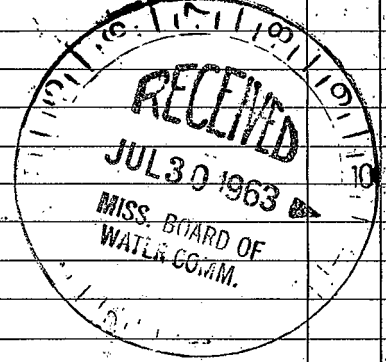

If YES depth of formation _____
 Why _____
 Drillers Remarks: _____

Well No.

(Use Back Side)

