

MADISON MISSISSIPPI BOARD OF WATER COMMISSIONERS

Q 23
9-63

WATER WELL DRILLERS LOG

CODED

Date: Sept., 1963, Driller: DAVID BERRY County: VAZOO
(Name)

LILLIAN BATTRELL

(1) Owner of Land: L & D Mann
(Name)
Alona, Miss
(Address)

(2) Location: 1/4, 1/4, Sec. 24 T8 R2W
4 miles W of Alona
(distance) (direction) (Nearest Town)

(3) Topography: _____
(Hilly) (Flat) (Level)

(4) Purpose of Well: Domestic
(Domestic Irrigation
Municipal, Industrial, Other)

Description & Color of Materials Sand, Clay, Red Clay, Shell, etc.	Thick- ness Feet	Depth Feet
Clay	20	20
Clay	17	37
Sand	3	40
Sand	2	42
Clay	18	60
Hard Clay	20	80
Blue Clay	20	100
Blue Clay	20	120
11 11	20	140
11 11	20	160
11 11	20	180
11 11	20	200
11 11	20	220
11 11	20	240
11 11	20	260
11 11	20	280
11 11	20	300
11 11	15	315
11 11	5	320
11 11	20	340
11 11	20	360
gravel & shell	14	250 2
Sand	18	520
gravel	10	530
Sand & clay	45	575
Sand	45	620
Clay	3	623
Sand	35	658
Sand	10	668
Gravel	10	678

Information upon completion of well:

(1) Diameter 4x2 inches.

(2) Total Depth 678 feet.

(3) Water Level 57' feet below top of ground.

(4) Cased to 315, Size 4"
358 2"


(5) Screen: Size 2', Length 30'

(6) Were any formations sealed against pollution?
_____ yes, _____ no.

If YES depth of formation _____

Why _____

Drillers Remarks: _____

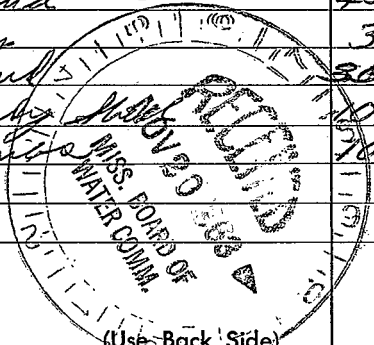

(Use Back Side)

Well No.

