

MADISON MISSISSIPPI BOARD OF WATER COMMISSIONERS

Q 24

11-63

WATER WELL DRILLERS LOG

Date: Nov, 1963, Driller: David Benny County

CODED

LILLIAN BOTTRELL
(Name)

(1) Owner of Land: L & D Hamm
(Name)
Flowa, Miss
(Address)

(2) Location: $\frac{1}{4}$, $\frac{1}{4}$, Sec. 36 T8 R2W
8 miles SW of Flowa
(distance) (direction) (Nearest Town)

(3) Topography: Hilly
(Hilly) (Flat) (Level)

(4) Purpose of Well: Domestic
(Domestic Irrigation
Municipal, Industrial, Other)

Description & Color of Materials Sand, Clay, Red Clay, Shell, etc.	Thick- ness Feet	Depth Feet
<u>Clay</u>	<u>540</u>	<u>540</u>
<u>Sand</u>	<u>60</u>	<u>620</u>

Information upon completion of well:

(1) Diameter 4 1/2 inches.

(2) Total Depth 620 feet.

(3) Water Level 147' feet below top of ground.

(4) Cased to 360, Size 4
200 2"


(5) Screen: Size 2, Length 30.

(6) Were any formations sealed against pollution?
____ yes, ____ no.

CODED

If YES depth of formation _____
Why _____

Drillers Remarks: _____

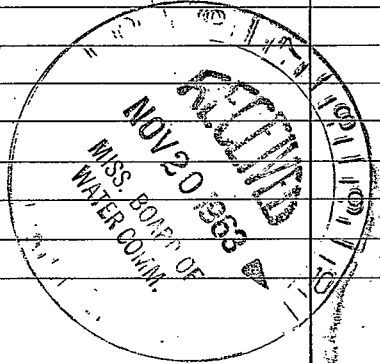

(Use Back Side)

Well No.

