

WATER WELL DRILLERS LOG

Date: 6-24, 1964, Driller: David Conroy
 (Name)

County: Yalobusha
CODED

(1) Owner of Land: E. K. Bardin
 (Name)
Aloua
 (Address)
 (2) Location: 1/4, 1/4, Sec. 36 T 8 R 2W
6 miles West of Aloua
 (distance) (direction) (Nearest Town)
 (3) Topography: Hilly
 (Hilly) (Flat) (Level)
 (4) Purpose of Well: Domestic
 (Domestic Irrigation Municipal, Industrial, Other)


Description & Color of Materials Sand, Clay, Red Clay, Shell, etc.	Thick-ness Feet	Depth Feet
Clay	25	25
Sand & sea gravel	10	35
Blue clay	35	70
Blue clay	31.1	101.1
" "	31.5	132.6
" "	31	163.6
" "	29.9	193.5
Shale	29.4	222.7
clay	313.3	536
clay	2	538
fine sand	52	590
fine sand	5	595
Brown shale	20	605
Brown shale	20	625
Brown shale	20.7	645.7
sand	20.4	665.1
sand	20.4	685.3
Sub. rocky sand	19.7	905.10

Information upon completion of well:

(1) Diameter 4 1/2 inches.
 (2) Total Depth 705 feet.
 (3) Water Level 113 feet below top of ground.
 (4) Cased to _____, Size _____
 (5) Screen: Size 2", Length 30
 (6) Were any formations sealed against pollution?
 _____ yes, _____ no.

If YES depth of formation _____
 Why _____
 Drillers Remarks: _____

CODED

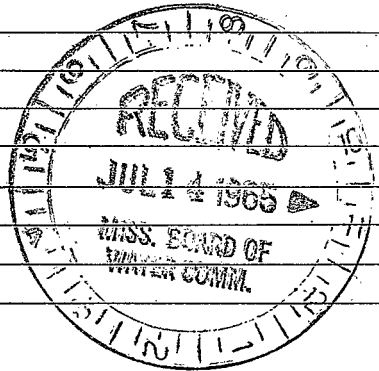

(Use Back Side)

Well No.

