

MADISON
Q 27
10-22-60

WATER WELL DRILLERS LOG

CODED

Date: Oct 22, 1960, Driller: M^r JAY DRAKE County MADISON

(Name)

(1) Owner of Land: Joseph Greel
(Name)
Flora Greel
(Address)

(2) Location: 1/4, 1/4, Sec. 33 T8 R2W
7 miles W, of Flora
(distance) (direction) (Nearest Town)

(3) Topography: (Hilly) (Flat) (Level)

(4) Purpose of Well: Home
(Domestic Irrigation
Municipal, Industrial, Other)

Information upon completion of well:

(1) Diameter 2 inches.

(2) Total Depth 580 feet.

(3) Water Level 148 feet below top of ground.

(4) Cased to _____, Size _____

(5) Screen: Size 006, Length 20ft


(6) Were any formations sealed against pollution?
_____ yes, no.

If YES depth of formation _____

Why _____

Drillers Remarks: _____

Description & Color of Materials Sand, Clay, Red Clay, Shell, etc:	Thick- ness Feet	Depth Feet
Red Clay	0	-21
21-23 Sand-Clay	21	42
Blue Clay	42	63
" "	63	84
" "	84	105
" "	105	126
" "	126	147
" "	147	168
" "	168	189
Blue Clay	189	210
" "	210	231
" "	231	252
" "	252	273
" "	273	294
" "	294	315
" "	315	336
" "	336	357
Some shells	357	378
Blue Clay	378	399
" "	399	420
" "	420	441
" "	441	462
Blue Clay	462	483
" "	483	504
" "	504	525
" "	525	546
" "	546	567
" "	567	588
Blue Shale	588	609
" "	609	630
" "	630	651
" "	651	672

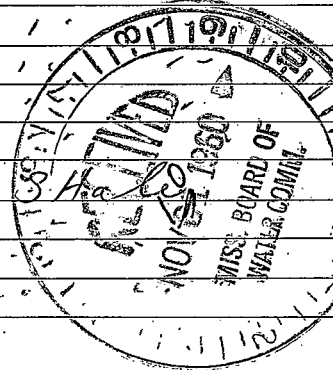

over (Use Back Side)

Well No.

10/21/50

M. J. D. D. M.

10/21/50

Jeffrey
M. J. D. D. M.

10/21/50

- 15-0
- 21-12
- 25
- 32
- 38
- 45
- 51
- 57
	W	↑
Blue clay —	678	699
" "	699	720
Blue Clay —	720	741
Fine Sand	741	762
Med Sand to Fine —	762	780
Med Sand —	780	
	802	
	811	

140

140