

Q 28


11-18-60

WATER WELL DRILLERS LOG

328
CODED

Date: NOV 18, 1960, Driller: M & KAY DRILLING County MADISON
(Name)

	Description & Color of Materials Sand, Clay, Red Clay, Shell, etc.	Thick- ness Feet	Depth Feet
(1) Owner of Land: <u>MR. HERRINGTON</u> (Name) <u>FLORA MISS</u> (Address)	<u>white clay</u>	0	21
(2) Location: $\frac{1}{4}$, $\frac{1}{4}$, Sec. <u>27 T8 R2W</u> <u>8</u> miles <u>W</u> of <u>FLORA</u> (distance) (direction) (Nearest Town)	<u>white clay</u>	21	42
(3) Topography: <input checked="" type="checkbox"/> (Hilly) <input type="checkbox"/> (Flat) <input type="checkbox"/> (Level)	<u>Blue Clay</u>	42	84
(4) Purpose of Well: <u>HOME</u> (Domestic Irrigation, Municipal, Industrial, Other)	" "	63	127
Information upon completion of well:	" "	84	181
(1) Diameter <u>2</u> inches.	<u>Blue clay to</u>	147	328
(2) Total Depth <u>825</u> feet.	<u>Shells and clay</u>	546	874
(3) Water level <u>127</u> feet below top of ground.	<u>Single and clay</u>	567	1441
(4) Cased to _____, Size _____	" "	588	2029
(5) Screen: Size <u>2"</u> <u>006</u> , Length <u>10ft</u>	<u>SANDY clay</u>	672	2701
(6) Were any formations sealed against pollution? _____ yes, <input checked="" type="checkbox"/> no.	" "	693	2894
If YES depth of formation _____	" "	714	3008
Why _____	<u>FINE SAND</u>	756	3764
Drillers Remarks: _____	" "	777	3941
	<u>FINE SAND</u>	798	4139
	<u>Set Seal</u>	825	4964
	<u>1 1/2 H.P. 3 1/2" dia. Jet Pump</u>		
	<u>at pit at 168' depth</u>		
	<u>8" gal. Pressure Pipe</u>		

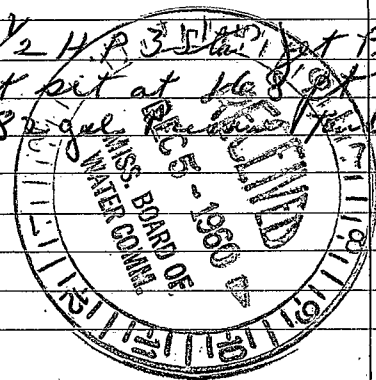

(Use Back Side)

Well No.

