

Q32

10-66

WATER WELL DRILLING

Date Oct 12, 1966, Driller: McKAY

County Madison
CODED

- (1) Owner of Land: Gill Watson
(Name)
Flora Mize
(Address)
- (2) Location: SE 1/4, NE 1/4, Sec 18 2
1 TN RW
5 miles NW of Flora
(distance) (direction) (Nearest Town)
- (3) Topography: (Hilly) (Flat) (Level)
- (4) Purpose of Well: Seed Sat
(Domestic Irrigation
Municipal, Industrial, Other)

Description & Color of Materials Sand, Clay, Red Clay, Shell, etc.	Thick- ness Feet	Depth Feet
<u>Red clay</u>	<u>20</u>	<u>20</u>
<u>white clay</u>	<u>20</u>	<u>40</u>
<u>Blue clay</u>	<u>220</u>	<u>260</u>
<u>Sandy Shale</u>	<u>40</u>	<u>300</u>
<u>Blue clay</u>	<u>200</u>	<u>500</u>
<u>Brown Shale</u>	<u>80</u>	<u>580</u>
<u>Fine Sand</u>	<u>60</u>	<u>640</u>
<u>Med Sand</u>	<u>30</u>	<u>720</u>

Information upon completion of well:


- (1) Diameter 4x2 inches.
- (2) Total Depth 720 feet.
- (3) Water Level 100 feet below top of ground.
- (4) Cased to 315, Size 4"
- (5) Screen: Size 007, Length 40
- (6) Were any formations sealed against pollution?
no

JHP Burk
70 gal min

CODED

If YES depth of formation _____
Why _____

Drillers Remarks: _____

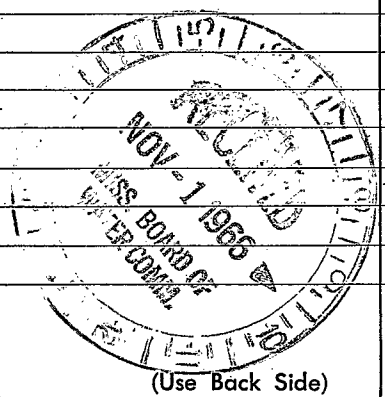

Well No.

