

MISSISSIPPI BOARD OF WATER COMMISSIONERS

E log 416 North State Street
#241 Jackson, Mississippi 39201

CODED

MADISON
Q33
9-12-76

WATER WELL DRILLERS LOG

9/12/76 date well completed 1976 Jack Guinn firm name MADISON county well located

LANDOWNER: Hugh Cummings farm

description of formations encountered	from	to
White Sand	0	110
YAZOO CLAY	110	600
Clay & Sand	600	810
Sand	810	902


JACKSON
(mailing address)

WELL LOCATION:
sec. 20 T. 8 N. R. 2 E
8 W
miles of
(distance) (direction) (nearest town)

WELL PURPOSE: HOME
(home, irrigation, municipal, industrial)

- WELL COMPLETION DATA:
- (1) diameter (inches) 2
 - (2) total depth (feet) 902
 - (3) static water level (feet) 108 below top of ground.
 - (4) casing IRON 810 (material), (depth)
2" if telescope see back. (size)
 - (5) screen 20' 830' (length), (depth to top)
2' STAINLESS STEEL (size), (material)
 - (6) pump 1 5 (HP), (yield gpm)
Electricity (type power)
 - (7) electric log YES (yes or no)
Ms. Geological Survey (organization running log)
 - (8) how well bottom plugged

CODED

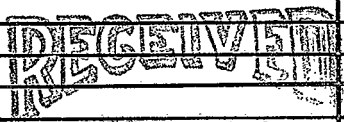


DEC 9 1976

DRILLERS REMARKS:

If well telescopes please
sketch and show depths.

GROUND LEVEL

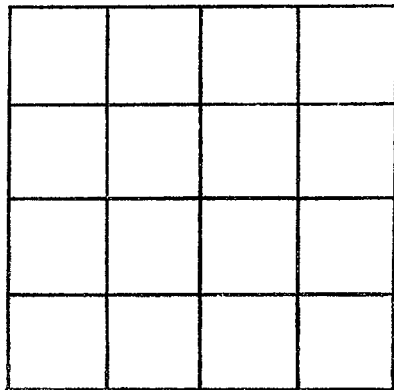

SECTION _____

Please indicate well location X.

ADDITIONAL INFORMATION

If more than one screen,
show locations of each on sketch.