

Madison
 Q 36
 6-29-79

MISSISSIPPI
 BOARD OF WATER COMMISSIONERS
 416 North State Street
 Jackson, Mississippi 39201

CODED

WATER WELL DRILLERS LOG

6/29
 date well completed

1979 E.M. "Bud" Cresswell
 firm name

Madison
 county well located

LANDOWNER:

George Shepherd
 Flora, MS.
 (mailing address)

description of formations
 encountered

from to

Clay	0	420
Barren Shale	420	525
Sand	525	620

WELL LOCATION:

sec. 11 T. 8 N R. 2 W
 4 miles West of Flora
 (distance) (direction) (nearest town)

WELL PURPOSE: Farm
 (home, irrigation, municipal, industrial)

WELL COMPLETION DATA:

- diameter (inches) 4
- total depth (feet) 620
- static water level (feet) 80 below top of ground
- casing PVC 580 (material) (depth)
 4 (size) If telescope see back.
- screen 40 580 (length) (depth to top)
 2 PVC (size) (material)
- pump 1 25 (HP) (yield gpm)
 0 (type power)
- electric log no (yes or no)
 0 (organization running log)
- how well bottom plugged
 Steel Plug

CODED

DRILLERS REMARKS:


Miss. Board of Water Comm.

JUL 5 1979

RECEIVED

If well telescopes please sketch and show depths.

GROUND LEVEL

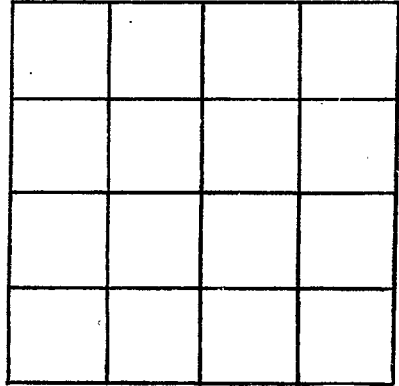

SECTION _____

Please indicate well location X.

ADDITIONAL INFORMATION

A series of horizontal lines for entering additional information, starting below the 'ADDITIONAL INFORMATION' header and extending to the bottom of the page.

If more than one screen, show locations of each on sketch.