

MISSISSIPPI DEPARTMENT OF NATURAL RESOURCES

Bureau of Land and Water Resources

Southport Mall

P.O. Box 10631

Jackson, Mississippi 39209

WATER WELL DRILLERS LOG

Q 39  
 Madison Co  
 4-10-84

COBED

April 10 1984 E.M. "Bud" Cresswell Madison  
 date well completed firm name county well located

LANDOWNER:	description of formations encountered	from	to
Mrs. R. R. Watson			
FLORA, MS. (mailing address)	yellow clay	0	70
	blue clay	70	520
	lime shell	520	690
	band	690	740
WELL LOCATION:			
sec. 2 T 8 R 2 3 miles West of Flora (distance) (direction) (nearest town)			
WELL PURPOSE: Storm (home, irrigation, municipal, industrial)			
WELL COMPLETION DATA:			
(1) diameter (inches) 4	COBED		
(2) total depth (feet) 740			
(3) static water level (feet) 90 below top of ground.			
(4) casing PVC 700 (material) (depth)			
4 (size) if telescope see back.			
(5) screen 40 700 (length) (depth to top)			
2 PVC (size) (material)			
(6) pump 1 20 (HP) (yield gpm)			
(7) electric log No (yes or no)			
(organization running log)			
(8) how well bottom plugged back wash valve			
DRILLERS REMARKS:			


DEPT. OF NATURAL RESOURCES  
 BUREAU OF LAND & WATER RESOURCES

APR 16 1984

RECEIVED

If well telescopes please sketch and show depths.

GROUND LEVEL

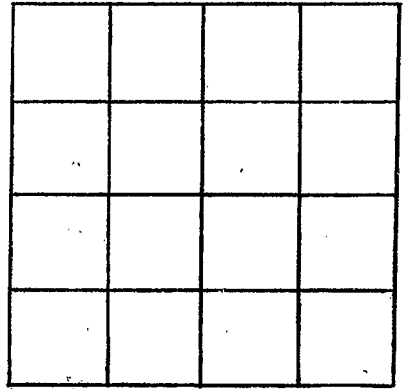

SECTION \_\_\_\_\_

Please indicate well location X.

ADDITIONAL INFORMATION

If more than one screen,  
show locations of each on sketch.