

MISSISSIPPI DEPARTMENT OF NATURAL RESOURCES

Bureau of Land and Water Resources

Southport Mall

P.O. Box 10631

Jackson, Mississippi 39209

WATER WELL DRILLERS LOG

CODED

MADISON
Q 40

July 18 1985 E.M. "Bud" CRESSWELL Madison
date well completed firm name county well located

LANDOWNER:
Wiles FARR
FLORA, MS. 39071
(mailing address)

description of formations encountered	from	to
Surface	0	45
Blue clay	45	590
Sandy shale	590	640
SAND	640	740

WELL LOCATION:
sec. 2 T. 8 N R. 2 W
4 miles West of Flora
(distance) (direction) (nearest town)

WELL PURPOSE: Home
(home, irrigation, municipal, industrial)

- WELL COMPLETION DATA:
- (1) diameter (inches) 4
 - (2) total depth (feet) 740
 - (3) static water level (feet) 110 below top of ground.
 - (4) casing PVC 700 (material), (depth)
4 (size) if telescope see back.
 - (5) screen 40 700 (length), (depth to top)
2 PVC (size), (material)
 - (6) pump 1 1/2 15 (HP), (yield gpm)
(type power)
 - (7) electric log No (yes or no)
(organization running log)
 - (8) how well bottom plugged Back wash valve


DRILLERS REMARKS:

CODED

RECEIVED
AUG 11 1985
Department of Natural Resources
Bureau of Land & Water Resources

If well telescopes please sketch and show depths.

GROUND LEVEL

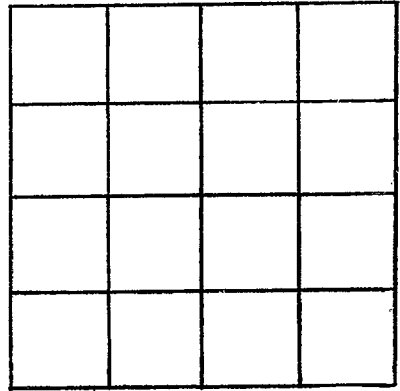

SECTION _____

Please indicate well location X.

ADDITIONAL INFORMATION

If more than one screen,
show locations of each on sketch.