

Madison  
 Q 200  
 4-8-77

MISSISSIPPI  
 BOARD OF WATER COMMISSIONERS  
 416 North State Street  
 Jackson, Mississippi 39201

WATER WELL DRILLERS LOG

April 8, 1977 E.M. "Bud" Cresswell Madison  
 date well completed firm name county well located


LANDOWNER	description of formations encountered	from	to
A.E. Crawford FLORA, MS. (mailing address)	Clay Sand	0	15 15 50
<b>WELL LOCATION:</b>			
sec. 3 T 8 N R 2 E 4 miles West of Flora (distance) (direction) (nearest town)			
<b>WELL PURPOSE:</b> farm (home, irrigation, municipal, industrial)			
<b>WELL COMPLETION DATA:</b>			
(1) diameter (inches) 4			
(2) total depth (feet) 50			
(3) static water level (feet) 8 below above top of ground.			
(4) casing PVC 40 (material) (depth) 4 if telescope see back. (size)			
(5) screen 10 40 (length) (depth to top)			
4 PVC (size) (material)			
(6) pump 1 30 (HP) (yield gpm)			
0 (type power)			
(7) electric log no (yes or no)			
0 (organization running log)			
(8) how well bottom plugged			
Spill plug			
DRILLERS REMARKS:			

RECEIVED

APR 12 1977

If well telescopes please sketch and show depths.

GROUND LEVEL

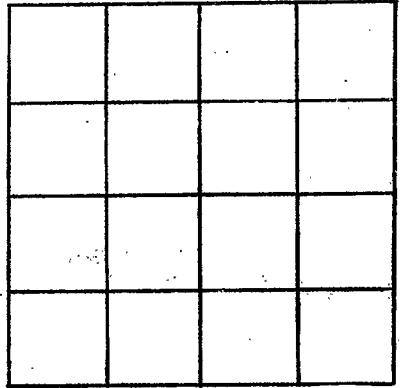

SECTION \_\_\_\_\_

Please indicate well location X.

ADDITIONAL INFORMATION

If more than one screen, show locations of each on sketch.