

MADISON MISSISSIPPI BOARD OF WATER COMMISSIONERS

R

5-20-64

WATER WELL DRILLERS LOG

Date: 5-20, 1964, Driller: CREE AND CRESSWELL County: MADISON

(Name)

- (1) Owner of Land: CHRIS
(Name)
FLORA, MISS.
(Address)
- (2) Location: 1/4, 1/4, Sec. T. R
1 miles SOUTH, of FLORA
(distance) (direction) (Nearest Town)
- (3) Topography: Hilly
(Hilly) (Flat) (Level)
- (4) Purpose of Well: DOMESTIC
(Domestic Irrigation
Municipal, Industrial, Other)

Description & Color of Materials Sand, Clay, Red Clay, Shell, etc.	Thick- ness Feet	Depth Feet
<u>YELLOW CLAY</u>	<u>40</u>	<u>40</u>
<u>BLUE CLAY</u>	<u>300</u>	<u>340</u>
<u>GREY SOX SHALE</u>	<u>300</u>	<u>640</u>
<u>GREY SAND</u>	<u>150</u>	<u>790</u>
<u>SHALE gummy</u>	<u>10</u>	<u>800</u>


Information upon completion of well:

- (1) Diameter 4 1/2 inches.
- (2) Total Depth 800 feet.
- (3) Water Level 130 feet below top of ground.
- (4) Cased to 300, Size 4"
- (5) Screen: Size , Length .
- (6) Were any formations sealed against pollution?
 yes, no.

If YES depth of formation 1 1/2 HP SUB

Why 120 GAL. TANK

Drillers Remarks:

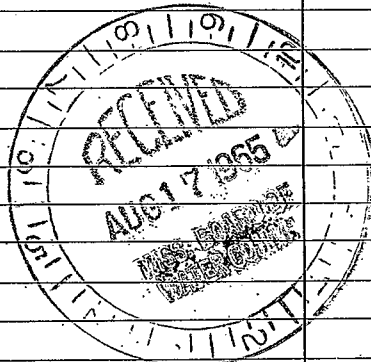

(Use Back Side)

Well No.

