

R 4

12-28-64

WATER WELL DRILLERS LOG

**CODED**

Date: 12/28, 1964, Driller: M. Kay County: Madison  
(Name)

(1) Owner of Land: Willie Horton  
(Name)  
Flora Mae  
(Address)

(2) Location: 1/4, 1/4, Sec. 22 T8 R1W  
4 miles S of Flora  
(distance) (direction) (Nearest Town)

(3) Topography:  (Hilly)  (Flat)  (Level)

(4) Purpose of Well: Home  
(Domestic Irrigation Municipal, Industrial, Other)

Description & Color of Materials Sand, Clay, Red Clay, Shell, etc.	Thick- ness Feet	Depth Feet
<u>Red Clay</u>	<u>0</u>	<u>21</u>
<u>Red Sand</u>	<u>2.7</u>	<u>63</u>
<u>Blue clay</u>	<u>6.3</u>	<u>609</u>
<u>fine sandy clay</u>	<u>6.09</u>	<u>693</u>
<u>Blue shale - clay</u>	<u>6.93</u>	<u>714</u>
<u>4ft Rock 715-719</u>	<u>715</u>	<u>719</u>
<u>Shale</u>	<u>719</u>	<u>735</u>
<u>Rock - shale</u>	<u>735</u>	<u>756</u>
<u>Rock - Shale - Shell</u>	<u>756</u>	<u>777</u>
<u>Sandy - Shale</u>	<u>777</u>	<u>819</u>
<u>fine sand</u>	<u>819</u>	<u>840</u>
<u>fine sand</u>	<u>840</u>	<u>861</u>
<u>fine med. sand</u>	<u>861</u>	<u>925</u>

Information upon completion of well:

(1) Diameter 4x2 inches.

(2) Total Depth 925 feet.

(3) Water Level 212 feet below top of ground.


(4) Cased to 430, Size 4"

(5) Screen: Size 007, Length 30

(6) Were any formations sealed against pollution?  
 yes,  no.

Set 252 ft 1/4 Day Pipe  
3/4 HP. Sub

**CODED**

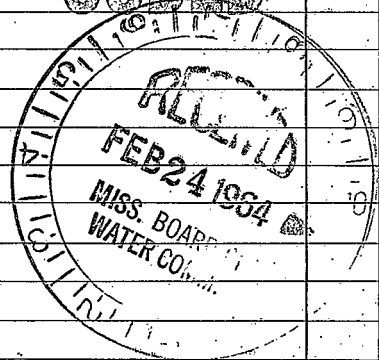

If YES depth of formation \_\_\_\_\_

Why \_\_\_\_\_

Drillers Remarks: \_\_\_\_\_

(Use Back Side)

Well No.

