

MADISON
 R 11
 9-17-68
 U.S.G.S.
 9-17-68

MISSISSIPPI
 BOARD OF WATER COMMISSIONERS
 416 North State Street
 Jackson, Mississippi 39201

CODED
 CODED

WATER WELL DRILLERS LOG

19 Robert E. Ruffin firm name Madison county well located

LANDOWNER Down of Flora, Miss.

description of formations encountered	from	to
Top Soil	0	20
Clay	20	390
Shale w/ sand streaks	390	520
Sand	520	566
Sand w/ shale streaks	566	600
Sand	600	610
Sandy shale	610	766
Finer Sand	766	809
Shale w/ sand streaks	809	973
Sand w/ shale streaks	973	1100
Shale w/ sand streaks	1100	1168
Sand	1168	1250
Shale	1250	1321
Sandy shale	1321	1392
Shale w/ sand streaks	1392	1461


(mailing address)

WELL LOCATION:
 sec. 17 T. 8 N. R. 1 E.
 S. W.
 (distance) miles Down (direction) (nearest town)

WELL PURPOSE: Municipal
 (home, irrigation, municipal, industrial)

- WELL COMPLETION DATA:
- diameter (inches) 12 x 8
 - total depth (feet) 1298
 - static water level (feet) 137 below above top of ground.
 - casing Galv Steel ~~Galv Steel~~ 1168
 (material) (depth)
12" If telescope see back.
 (size)
 - screen 60' 1168
 (length) (depth to top)
8 S.S.
 (size) (material)
 - pump 60 558
 (HP) (yield gpm)
electric
 (type power)
 - electric log yes
 (yes or no)
U.S.G.S.
 (organization running log)
 - how well bottom plugged BPU

DRILLERS REMARKS:

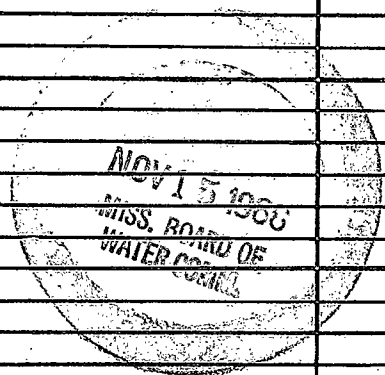

(X)

If well telescopes please sketch and show depths

GROUND LEVEL

SECTION _____

Please indicate well location X.

ADDITIONAL INFORMATION

If more than one screen, show locations of each on sketch.