

MADISON
R 12
8-11-72

MISSISSIPPI
BOARD OF WATER COMMISSIONERS
416 North State Street
Jackson, Mississippi 39201

WATER WELL DRILLERS LOG

CODED

Aug. 11 1972 E.M. "Bud" Cresswell MADISON
date well completed firm name county well located

LANDOWNER:
Tim Vaughn
FLORA, Miss.
(mailing address)

description of formations encountered	from	to
Clay	0	30
Sand	30	45
Clay	45	340
bed	340	420

WELL LOCATION:
sec. 4 T 8 N R 1 E W
1 miles N of FLORA
(distance) (direction) (nearest town)

WELL PURPOSE: Domestic
(home, irrigation, municipal, industrial)

- WELL COMPLETION DATA:
- (1) diameter (inches) 2
 - (2) total depth (feet) 420
 - (3) static water level (feet) 60 below top of ground.
 - (4) casing Steel, 400
(material) (depth)
2 If telescope see back.
(size)
 - (5) screen 20, 400
(length) (depth to top)
2, Stainless
(size) (material)
 - (6) pump air compressor
(HP) (yield/gpm)
0
(type power)
 - (7) electric log No
(yes or no)
0
(organization running log)
 - (8) how well bottom plugged
Steel plug


CODED

SEP 7 1972

DRILLERS REMARKS:

If well telescopes please sketch and show depths.

GROUND LEVEL

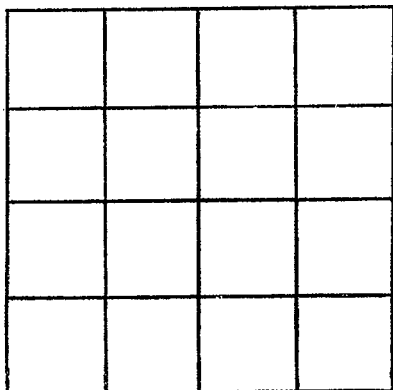

SECTION _____

Please indicate well location X.

ADDITIONAL INFORMATION

If more than one screen, show locations of each on sketch.