

MADISON

MISSISSIPPI BOARD OF WATER COMMISSIONERS

R13

1-5-63

WATER WELL DRILLERS LOG

CODED

Date: 1-5, 1963, Driller: BUD CRESTMAN, County: MADISON

(Name)

(1) Owner of Land: PETRIFIED

(Name)

FOREST FLORA

(Address)

(2) Location: 1/4, 1/4, Sec. 29 T8R14

2 miles S-W of FLORA

(distance)

(direction)

(Nearest Town)

(3) Topography: HILLY

(Hilly)

(Flat)

(Level)

(4) Purpose of Well: DOMESTIC

(Domestic Irrigation, Municipal, Industrial, Other)

Description & Color of Materials Sand, Clay, Red Clay, Shell, etc.	Thick- ness Feet	Depth Feet
RED CLAY	20	20
BLUE CLAY	440	460
GREENISH SAND		
SAND SEA SHELLS	30	490
GREY SHALE		
with STR. SAND	51	541
SANDY SHALE	243	784
GREY COARSE		
SAND	62	846

Information upon completion of well:

(1) Diameter 4x2 inches.

(2) Total Depth 846 feet.

(3) Water Level 127 feet below top of ground.

(4) Cased to 826, Size 4x2

(5) Screen: Size 2" Length 20


(6) Were any formations sealed against pollution?

yes, no.

If YES depth of formation

Why

Drillers Remarks:

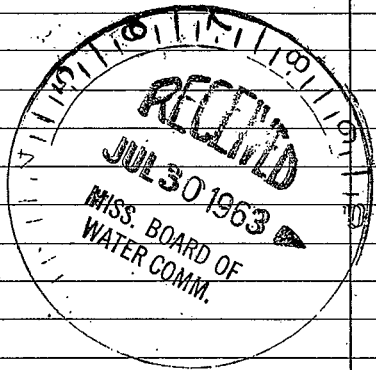

CODED

Well No.

(Use Back Side)

