

MISSISSIPPI
BOARD OF WATER COMMISSIONERS
416 North State Street
Jackson, Mississippi 39201

CODED

MADISON
R 14
8-3-73

WATER WELL DRILLERS LOG

Aug. 3 1973 E. M. "Bud" Cresswell Madison
date well completed firm name county well located

LANDOWNER:

Ernest Greenfield
Flow, Miss.
(mailing address)

description of formations encountered

Clay
Sand

from

to

0 35
35 110

WELL LOCATION:

sec. 23 T 8 N R 1 E
3 miles S.E. of Flow
(distance) (direction) (nearest town)

WELL PURPOSE:

Home
(home, irrigation, municipal, industrial)

WELL COMPLETION DATA:

(1) diameter (inches) 2
(2) total depth (feet) 110
(3) static water level (feet) 60 below top of ground.

(4) casing Steel 105
(material) (depth)
2 (size) if telescope see back.

(5) screen 5 105
(length) (depth to top)

2 Stainless
(size) (material)

(6) pump 1 10
(HP) (yield gpm)
0 (type power)

(7) electric log No
(yes or no)

0
(organization running log)

(8) how well bottom plugged

Steel plugs


DRILLERS REMARKS:

CODED

AUG 7 1973

If well telescopes please sketch and show depths.

GROUND LEVEL

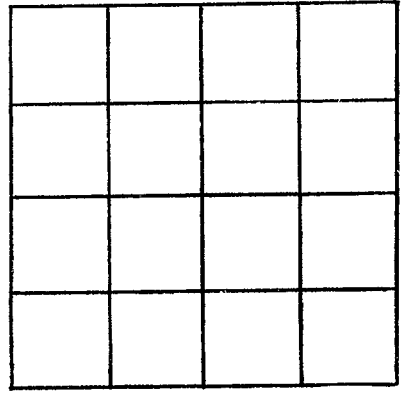

SECTION _____

Please indicate well location X.

ADDITIONAL INFORMATION

If more than one screen,
show locations of each on sketch.