

MADISON
R 16
9-30-74

MISSISSIPPI
BOARD OF WATER COMMISSIONERS
416 North State Street
Jackson, Mississippi 39201

WATER WELL DRILLERS LOG

CODED

Sept. 30 1974 E.M. "Bud" Cresswell Madison
date well completed firm name county well located

LANDOWNER:
J.V. McCullough
FLORA, Miss.
(mailing address)

description of formations encountered	from	to
Clay	0	260
hard few shells	260	300
shale	300	360
band	360	460

WELL LOCATION:
sec 3 T 8 N R 1 E
3 miles EAST of FLORA
(distance) (direction) (nearest town)

WELL PURPOSE: Home
(home, irrigation, municipal, industrial)

- WELL COMPLETION DATA:
- (1) diameter (inches) 2
 - (2) total depth (feet) 460
 - (3) static water level (feet) 165 below top of ground.
 - (4) casing Steel 440 (material) (depth)
2 (size) if telescope see back.
 - (5) screen 20 440 (length) (depth to top)
2 Stainless (size) (material)
 - (6) pump Air Compressor (HP) (y/d/d. gpm)
(type power)
 - (7) electric log (yes or no)
(organization running log)
 - (8) how well bottom plugged
flow plug


DRILLERS REMARKS:

RECEIVED
OCT 22 1974

MISS. BD. OF WATER COMMISSIONERS

If well telescopes please sketch and show depths.

GROUND LEVEL

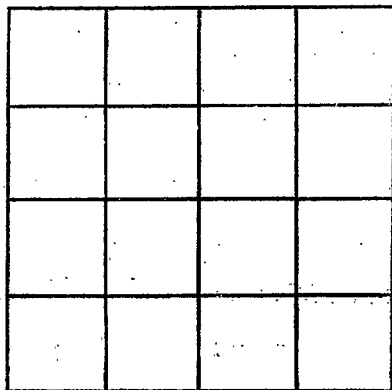

SECTION _____

Please indicate well location X.

ADDITIONAL INFORMATION

If more than one screen, show locations of each on sketch.