

MADISON
R17
~~2-27-75~~
Flog# 233

MISSISSIPPI
BOARD OF WATER COMMISSIONERS
 416 North State Street
 Jackson, Mississippi 39201

CODED

~~4-16~~ 19 75 W. G. Butler Madison
 date well completed firm name county well located

WATER WELL DRILLERS LOG

LANDOWNER:
 Earl Bryan Mahaffey
 Flora, Miss - Rt.
 (mailing address)

description of formations encountered	from	to
Chalk + clay	0	30
Fine sand	30	40
Chalk	40	180
Yazoo clay	180	500
Fine sand, Chalk	500	772
+ Shale		

WELL LOCATION:
 sec 25 T 8 N R 1 E
 SW/4 NW/4 SW/4
6 miles N.E of Pocahontas
 (distance) (direction) (nearest town)

WELL PURPOSE: Home
 (home, irrigation, municipal, industrial)

- WELL COMPLETION DATA:**
- (1) diameter (inches) 2"
 - (2) total depth (feet) 772'
 - (3) static water level (feet) 160 ^{below} top of ground.
 - (4) casing galv. 752'
 (material) (depth)
2" If telescope see back.
 (size)
 - (5) screen 20 752'
 (length) (depth to top)
2" S.S. Screen
 (size) (material)
 - (6) pump 5 air Comp.
 (HP) (yield gpm)
Electric 20
 (type power)
 - (7) electric log yes
 (yes or no)
Miss. Geological Sur.
 (organization running log)
 - (8) how well bottom plugged B.W.V.

if more information is needed - check with John Mashke Miss. Geo. Survey

RECEIVED


APR 21 1975

MISS. BD. OF WATER COMM.

DRILLERS REMARKS:
Best sand 752 to 772'

If well telescopes please sketch and show depths.

GROUND LEVEL

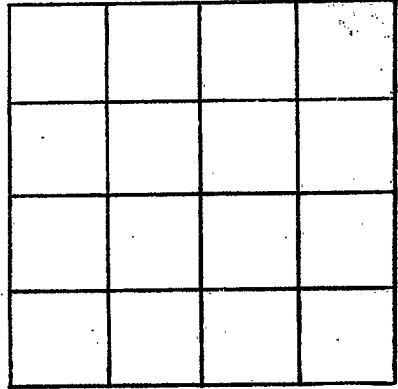

SECTION _____

Please indicate well location X.

ADDITIONAL INFORMATION

If more than one screen, show locations of each on sketch.