

MADISON
#43 R20

11/20/78
E log # 249

Nov. 20 1978
date well completed

MISSISSIPPI
BOARD OF WATER COMMISSIONERS
416 North State Street
Jackson, Mississippi 39201

CODED

250 WATER WELL DRILLERS LOG

78 E.M. "Bud" CRESWELL
firm name
MADISON
county well located

LANDOWNER:
MATT FLINT
FLORA, MS.
(mailing address)

description of formations encountered	from to	
Surface	0	20
Clay	20	470
Sandy shale	470	650
Sand	650	780

WELL LOCATION:
sec 26 T 8 N R 1 E
4 miles South of Flora
(distance) (direction) (nearest town)

WELL PURPOSE: Home
(home, irrigation, municipal, industrial)

- WELL COMPLETION DATA:
- (1) diameter (inches) 4
 - (2) total depth (feet) 780
 - (3) static water level (feet) 160 below top of ground.
 - (4) casing Steel, 700 (material), (depth)
2 (size) if telescope see back.
 - (5) screen 40, 700 (length), (depth to top)
2, stainless (size), (material)
 - (6) pump 3, 25 (HP), (yield gpm)
0 (type power)
 - (7) electric log yes (yes or no)
Steel (organization running log)
 - (8) how well bottom plugged Steel Plug

CODED


RECEIVED
DEC - 5 1978

DRILLERS REMARKS:

MISS. BD. OF WATER COMMISSIONERS

If well telescopes please sketch and show depths.

GROUND LEVEL

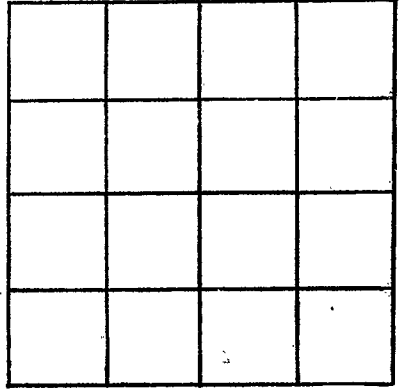

SECTION _____

Please indicate well location X.

ADDITIONAL INFORMATION

If more than one screen,
show locations of each on sketch.