

MADISON
R21
2/15/79
Elog #251

MISSISSIPPI
BOARD OF WATER COMMISSIONERS
416 North State Street
Jackson, Mississippi 39201

CODED

WATER WELL DRILLERS LOG

Feb. 15 1979 E.M. "Bud" CRESSWELL Madison
date well completed firm name county well located

LANDOWNER:
LEE Matt
FLORA, MS.
(mailing address)

description of formations encountered	from to	
Clay	0	420
Sand - sea shells	420	450
Shale and sandy shale	450	680
Sand	680	750
Sandy shale	750	820

WELL LOCATION:
sec 25 T 8 N R 1 E
15 miles SE of FLORA
(distance) (direction) (nearest town)

WELL PURPOSE: home
(home, irrigation, municipal, industrial)

- WELL COMPLETION DATA:
- (1) diameter (inches) 4 X 2
 - (2) total depth (feet) 750
 - (3) static water level (feet) 170 below top of ground.
 - (4) casing Steel, 710 (material), (depth)
 - 2 (size) If telescope see back.
 - (5) screen 40, 710 (length), (depth to top)
 - 2, STAINLESS (size), (material)
 - (6) pump 1 1/2, 12 (HP), (yield gpm)
 - 0 (type power)
 - (7) electric log yes (yes or no)
State (organization running log)
 - (8) how well bottom plugged
Steel plug

CODED

Miss. Board of Water Comm.


MAR 13 1979

RECEIVED

DRILLERS REMARKS:

If well telescopes please sketch and show depths.

GROUND LEVEL

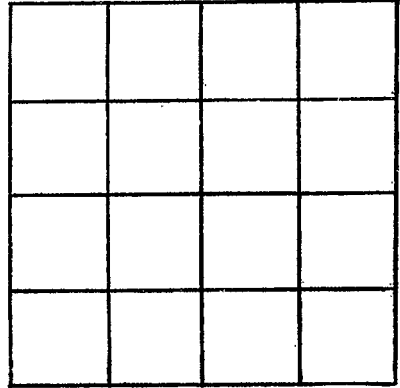

SECTION _____

Please indicate well location X.

ADDITIONAL INFORMATION

If more than one screen,
show locations of each on sketch.