

CODED

MADISON
R26
2-3-84

MISSISSIPPI
 BOARD OF WATER COMMISSIONERS
 416 North State Street
 Jackson, Mississippi 39201

CODED

WATER WELL DRILLERS LOG

Quinn Well Serv.

Madison

date well completed 19 84 firm name Quinn Well Serv. county well located Madison

LANDOWNER: Lennie Johnson description of formations encountered from to

(mailing address)

WELL LOCATION:
 sec. 26 T 9 N S R 1 E W 2
 (distance) miles (direction) of (nearest town) Wells

WELL PURPOSE:
 (home, irrigation, municipal, industrial)

WELL COMPLETION DATA:

(1) diameter (inches) _____

(2) total depth (feet) _____

(3) static water level (feet) _____ below above top of ground.

(4) casing _____ (material) _____ (depth) _____
 _____ (size) If telescope see back.

(5) screen _____ (length) _____ (depth to top) _____
 _____ (size) _____ (material)

(6) pump _____ (HP) _____ (yield gpm) _____
 _____ (type power)

(7) electric log _____ (yes or no) Jo - 1984
E Lloyd
 (organization running log)

(8) how well bottom plugged _____


CODED

*Res. - YFW
1-7-85*

DRILLERS REMARKS:

If well telescopes please sketch and show depths.

GROUND LEVEL

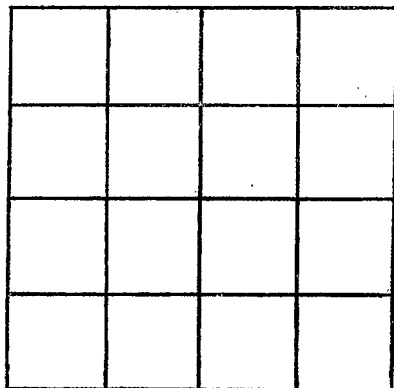

SECTION _____

Please indicate well location X.

ADDITIONAL INFORMATION

If more than one screen,
show locations of each on sketch.