

MISSISSIPPI DEPARTMENT OF NATURAL RESOURCES

Bureau of Land and Water Resources

P.O. Box 10631

Jackson, Mississippi 39209

WATER WELL DRILLERS LOG

COUNTY WELL LOCATED Madison	
WELL NUMBER 1 R27	CODED <input checked="" type="checkbox"/>
DATE WELL COMPLETED	

PERMIT NUMBER
NAME OF DRILLING FIRM Parkins WATER Well Service

NAME & MAILING ADDRESS OF LANDOWNER Bingham Shaw		
 Hwy 22 E		
 Flora ms.		
WELL LOCATION: SEC	TOWNSHIP	RANGE
11	8 N	1 E
DISTANCE	DIRECTION	NEAREST TOWN
3 Miles	EAST of	Flora
OTHER LANDMARK		
WELL PURPOSE: Home, Irrigation, Municipal, Industrial, Fish Pond, etc. Home		

PUMP DATA		
PUMP TYPE (Circle One): <input checked="" type="checkbox"/> Submersible, Turbine, Jet, Flowing Well, Other (Describe) _____		
POWER TYPE (Circle One): <input checked="" type="checkbox"/> Electric, Tractor, Diesel, Gasoline, Butane, Other (Describe) _____ H/P 1		
Pump Capacity (GPM)	No. of Stages	Setting Depth
10 gal/min		300 FT.
PUMP TEST		
Well yielded 10 GPM with a drawdown of 30 ft. after 8 hours of pumping		

WELL DATA		
Well Depth 400'	Casing Diameter (In.) 4 in	Casing Length (Ft.) 360
Type of Casing PVC	Hole Depth 400	Depth to Static Water Level 140'
TYPE OF COMPLETION: (Circle One or More): <input checked="" type="checkbox"/> Gravel Packed, <input type="checkbox"/> Underreamed, <input type="checkbox"/> Telescoped, <input checked="" type="checkbox"/> Natural Development, <input type="checkbox"/> Open Hole, <input type="checkbox"/> Other (Describe) START Well		
Top of Lap Pipe or Reduction in Casing		
FEET	IF TELESCOPED OR MORE THAN ONE SCREEN: USE BACK PAGE	

LOG DATA	
TYPE OF LOG RUN (Circle One): <input checked="" type="checkbox"/> Electric, Gamma Ray, Density, Sonic, Neutron, Other (Describe) _____ No Log Run	
Name of Organization Running Log STATE	

SCREEN DATA		
Diameter - Inches 4 in	Length - Feet 40 ft	Slot Size - Inches 10
Screen Type PVC	Depth to Bottom - Feet 400 FT	

GEOLOGIC DATA (Office Use Only)			
Surface Elev.	Geologic Unit	Unit Thickness	Depth to Top
Subs. SWL	Date	Analysis	Aquifer Test

Driller's Remarks

DESCRIPTION OF FORMATIONS ENCOUNTERED	FROM	TO	FORMATIONS (Continued)
Red Clay	0	20	
UA 300 Clay	20	360	
SAND	360	400	
<p style="font-size: 1.2em; font-weight: bold;">APR 25 1989</p>			
<p style="font-weight: bold;">Department of Natural Resources Bureau of Land & Water Resources</p>			
IF MORE SPACE IS NEEDED, USE BACK			


If well telescopes please sketch and show depths.

GROUND LEVEL

SECTION _____

Please indicate well location X.

ADDITIONAL INFORMATION

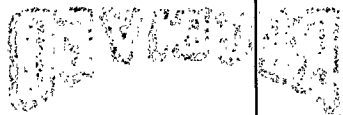

If more than one screen,
show location of each on sketch.