

County: Madison
 Permit #: _____
 Driller: Andy Lewis
 Date drilling completed: 7-19-07

State Well Report
Part I - Driller's Log
 Mississippi Department of Environmental Quality
 Office of Land and Water Resources
 P.O. Box 10631
 Jackson, MS 39289-0631
 (601)961-5210
 (601)354-6938 (fax)

For Office Use Only:
 Aquifer: _____
 Well #: R-36
 L. S. Elevation: _____
 B-log #: _____

State Law requires that this report be prepared by the licensee holder responsible for the work and filed with the Department at the above address within 30 days of completion of drilling of the well or borehole.

Information on Well Owner <i>(Landowner if borehole is not for a water well)</i>	Well or Borehole Location
Owner Name: <u>Richard Kostick</u>	Latitude: <u>32.31.17</u> Longitude: <u>90.14.48</u>
Mailing Address: <u>184 Lake Hill Dr.</u>	Method of Lat/Long (circle one): Conventional Survey, <u>Hand-held GPS</u> , Survey-grade GPS
<u>Flora</u> <u>Ms</u> <u>39071</u>	USGS quad: <u>NE 1/4 SE 1/4 Sec 29 Twn 8N Rng 1W</u>
City State Zip Code	Distance Direction Nearest Town
Telephone No. () _____	<u>15</u> Miles <u>W</u> of <u>Flora</u>

See
Attc

Well / Borehole Data

Date drilling started: 7-16-07 Date drilling completed: 7-19-07 Hole depth: 225 Hole diameter: 4 1/4

Location of the source of any surface water used for drilling: _____
 Method of dosing and volume of Chlorine used in drilling and development: _____

Logs run (circle all applicable): No log run Electric Gamma Ray Density Sonic Neutron Other: _____
 Name of organization running log(s): _____

Purpose of borehole (check one): Water Well _____ Geotechnical/Geological Investigation _____ Ground Source Heat Pump
 Seismic Survey _____ Other (describe) _____
If drilling is not related to water well construction, skip the remainder of this block

Purpose of Well (check one): Home _____ Industrial _____ Public Supply _____ Irrigation _____ Fish Culture _____ Other: _____

If a flowing well, method of flow regulation: Valve _____ Other (describe) _____

Static Water Level: _____ feet above or below (circle one) land surface Date measured: _____

Method of Measurement (circle one) steel tape electric tape air line other: _____

Well depth: _____ Well grouted to a depth of _____ feet Type of grout (circle one): Neat Cement Bentonite Mix

Casing length: _____ feet Casing diameter: _____ inches Type of casing: _____

Screen length: _____ feet Screen diameter: _____ inches Type of screen: _____

Screen slot size: _____ inches Setting depth: From _____ feet to _____ feet

Type of completion (circle all applicable): Gravel packed Underreamed Telescoped Open hole Natural Development
 Other (describe): _____

Top of lap pipe or reduction in casing: _____ feet. *If telescoped or more than one screen, describe on next page*

RECEIVED
AUG 03 2007
BY: OLWR

R-37


Richard Kostick
184 LAKE HILL Dr
FLORA, MS.

A	B
16'	43'
30' 8"	50'
46' 7"	61'
62'	71'
38' 6"	15' 6"
47' 6"	30' 6"
57' 6"	46'
69'	61' 6"
82' 8"	78' 6"

GPS-1 32° 31' 18" N
090° 14' 46" W

GPS-2 32° 31' 17" N
090° 14' 48" W

- 9 •
- 8 •
- 7 * GPS-2
- 6 •
- 5 •

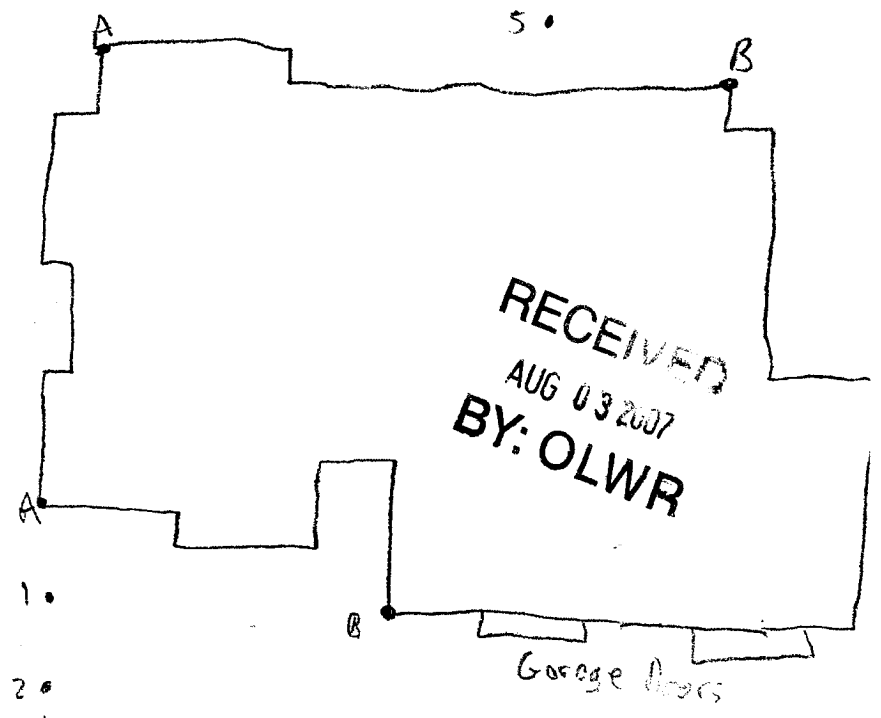

- 1 •
- 2 •
- * GPS-1
- 3 •
- 4 •

