

State Well Report

Part 1 - Driller's Log

Mississippi Department of Environmental Quality
Office of Land and Water Resources
P.O. Box 2309
Jackson, MS 39225
(601)961- 5210
(601)961- 5228 (fax)

County: Madison
Permit #: MS-GW-17078
Driller: Griner Drilling
Date drilling completed: 2-15

For Office Use Only:

Aquifer: _____
Well #: R38
L. S. Elevation: 252
E-log #: _____

State Law requires that this report be prepared by the license holder responsible for the work and filed with the Department at the above address within 30 days of completion of drilling of the well or borehole.

Information on Well Owner (Landowner if borehole is not for a water well)	Well or Borehole Location
Owner Name: <u>Town of Flora</u>	Latitude: <u>32.565797</u> Longitude: <u>-90.322970</u>
Mailing Address: <u>168 Carter Street</u>	Method of Lat/Long (circle one): Conventional Survey, USGS quad, Hand-held GPS, Survey-grade GPS
<u>Flora, MS 39071</u>	<u>NE</u> ¼ <u>SW</u> ¼ Sec <u>05</u> Twn <u>08N</u> Rng <u>01W</u>
City State Zip Code	Distance Direction Nearest Town
Telephone No. ()	<u>0</u> Miles <u>C</u> of <u>Flora</u>

Well / Borehole Data

Date drilling started: 1-14 Date drilling completed: 2-15 Hole depth: 1400 Hole diameter: 9 7/8

Location of the source of any surface water used for drilling: Public Water supply
Method of dosing and volume of Chlorine used in drilling and development: NA

Logs run (circle all applicable): No log run Electric Gamma Ray Density Sonic Neutron Other: _____
Name of organization running log(s): Griner Drilling

Purpose of borehole (check one): Water Well ___ Geotechnical/Geological Investigation ___ Ground Source Heat Pump ___
Seismic Survey ___ Other (describe) _____

If drilling is not related to water well construction, skip the remainder of this block

Purpose of Well (check one): Home ___ Industrial ___ Public Supply Irrigation ___ Fish Culture ___ Other: _____

If a flowing well, method of flow regulation: Valve ___ Other (describe) _____

Static Water Level: 224 feet above of below (circle one) land surface Date measured: 1-23-15

Method of Measurement (circle one) steel tape electric tape air line other: _____

Well depth: 1280 Well grouted to a depth of 1100 feet Type of grout (circle one): Neat Cement Bentonite Mix

Casing length: 1100 feet Casing diameter: 12 inches Type of casing: steel

Screen length: 80 feet Screen diameter: 8 inches Type of screen: Stainless wire wrap

Screen slot size: .20 inches Setting depth: From 1260 feet to 1280 feet

Type of completion (circle all applicable): Gravel packed Underreamed Telescoped Open hole Natural Development

Other (describe): _____

Top of lap pipe or reduction in casing: 1080 feet. *If telescoped or more than one screen, describe on next page*

Form: OLWR-SWR-1A (04/08)



STATE WELL REPORT

Part 2

Pump Installer's Completion Report
 Mississippi Department of Environmental Quality
 Office of Land and Water Resources
 P.O. Box 2309
 Jackson, MS 39225
 (601)961-5210
 (601)961-5228 (fax)

County: Madison
 Permit #: MS-GW-17078
 Driller: Griner Drilling
 Date completed: 2-15
Copy information from block on Part 1

For Office Use Only:

Aquifer: _____
 Well #: R38
 Elevation: _____

This part of the report must be completed by a licensed water well contractor or a licensed pump installer. A copy of Part 1 of the report must be attached and both parts filed with the Department at the above address within 30 days of well completion.

Well Owner Information	Well Location
Owner Name: <u>Town of Flora</u>	Latitude: <u>32.565797</u> Longitude: <u>90.322970</u>
Mailing Address: <u>168 Carter Street</u>	Method of Lat/Long (check one): Conventional Survey _____, USGS quad _____, Hand-held GPS _____, Survey-grade GPS _____ _____ 1/4 _____ 1/4 Sec _____ T _____ R _____
<u>Flora</u> <u>MS</u> <u>39071</u> City State Zip Code	Distance _____ Direction _____ Nearest Town <u>Flora</u> _____ Miles _____ of _____
Telephone No. (____) _____	

Pump Type Circle one	Power Type Circle one
Air Lift <input type="checkbox"/> Jet <input type="checkbox"/> Submersible <input type="checkbox"/>	Diesel Engine <input type="checkbox"/> Gasoline Engine <input type="checkbox"/> Natural Gas <input type="checkbox"/>
Bucket <input type="checkbox"/> Piston <input type="checkbox"/> Turbine <input checked="" type="checkbox"/>	Electric Motor <input checked="" type="checkbox"/> Hand <input type="checkbox"/> Tractor PTO <input type="checkbox"/>
Centrifugal <input type="checkbox"/> Rotary <input type="checkbox"/> Flowing Well <input type="checkbox"/>	Windmill <input type="checkbox"/> Other (specify): _____
Other (specify): _____	Horse Power Rating of Motor: <u>100</u>
Date Pump Installed: _____	Setting Depth: <u>320</u> feet
Rated Pump Capacity: <u>500</u> Gallons Per Minute	Number of Stages: <u>10</u>

Pump Test Data	Method of Measuring Water Level Circle one
Date Well Tested: <u>1-23-15</u>	Air Line <input type="checkbox"/> Electric Measuring Line <input checked="" type="checkbox"/> Steel Tape <input type="checkbox"/>
Static Water Level (A): <u>219</u> Feet Below Land Surface	Other (specify): _____
Pumping Water Level (B): <u>231</u> Feet Below Land Surface	For flowing well, measured shut in head: <u>NA</u> feet
Drawdown [(B) - (A)]: <u>12</u> Feet Below Land Surface	Well yielded <u>506</u> GPM with a drawdown of <u>12</u> feet after <u>4</u> hours of pumping
Test Pumping Rate: <u>506</u> Gallons Per Minute	
Duration of Pump Test (minimum 4 hours): <u>4</u> hours	

This is for (circle one): **New Well** Replacement of Existing Pump Repair of Existing Pump

I HEREBY CERTIFY that the above statements are true to the best of my knowledge.

Ryan Herndon 0-70042
 Print Name of Pump Installer and License No. (if applicable)

[Signature]
 Signature of Pump Installer

Form: OLWR-SWR-1C (07-09)



PROJECT Flora DRILLER Chris Renaldo JOB # 2013RM1005
 LOCATION JW Richardson Rd DATE COMPLETED 2/15 TEST HOLE 1380 FT.
 ENGINEER Brian G. Granger - Waggoner Engineering, Inc.

WELL DATA

Well Depth 1280 ft.

CASING Size 12 in. Material A53 Grade B Coated
 Length 1190 ft. Coating Yes - 12 mills

CEMENT Grout Type Neat cement No. of Sacks _____

LAP PIPE Size 8 in. Material A53 Grade B Coated OD & ID
 Length 120 ft. Type of Seal Gravel Wall

SCREEN Size 8 in. Brand Johnson
 Length 80 ft. Material Stainless Wire Wrap Slot size .20
 Backwash Valve Yes Material Bronze

GRAVEL PACK Cubic Yards 5.5 Size of Underreamed Hole 12 in.

HYDRAULICS Static Water Level 219 ft. Pumping Water Level 231 ft.
 Drawdown 11 ft. Specific Capacity 46 gal./ft.
 Total Dynamic Head 455 ft. Capacity 506 GPM

CHLORINATOR Superior

PUMP DATA

DISCHARGE HEAD X Oil Lube _____ Water Lube _____
 Solenoid 460 Volts Discharge 8 in.

COLUMN Size 6 in. Material Black Steel Coating Yes
 Length 320 ft. Oil Lube 2 / in. Shafting 1 1/4


BOWL ASSEMBLY Make American Serial No. 10M55 Stages 10
 Diameter 10 in. Material Cast
 Suction Size 6 in. Length 20 ft.
 Air Line Length 320 ft. Material Stainless

ELECTRIC MOTOR DATA

MOTOR Vertical Hollow Shaft 100 HP 1800 RPM 3 Phase
 Model / Make US 480 Volts 60 Cycles
 Base Diameter 18 in. Ratchet _____ Self releasing X Non reverse
 Other _____

CONTROL PANEL DATA

STARTER Size & Make Allen Bradley Soft Start **HEATER** Size & Make Electronic
 Breaker 400 AMP Fuse _____
460 Volts 3 Phase Delta Service _____ Open X Closed

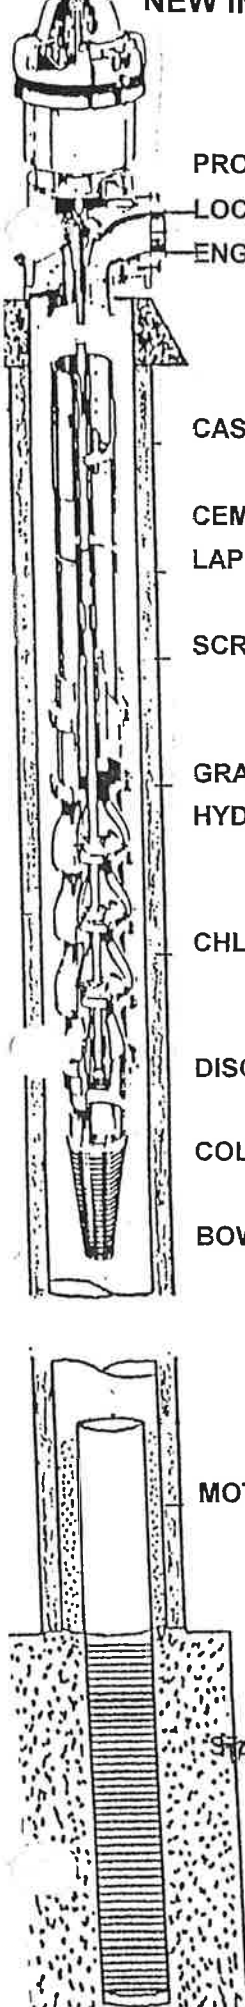

Driller's Log
Town of Flora
2/4/2014



DEPTH	DESCRIPTION
0-32	fill dirt, clay, gray clay
32-60	gray clay
60-91	gray clay
91-120	gray clay
120-151	gray clay
151-183	gray clay
183-214	gray clay, brown clay stks
214-246	gray clay
246-277	gray clay
277-308	clay, gray clay
308-338	gray clay, clay
338-369	sndy clay & sndy & shell stks
369-401	sndy cly/clay
401-432	clay/lignite stks/sandy stks
432-464	clay, sand stks, sand/shell brk, lignite stks
464-495	mostly sand
495-526	mostly sand
526-557	sand, clay, brown clay, gray clay, shell brk @ 532
557-589	sandy clay
589-620	sandy clay, lignite stks
620-651	sandy clay, gray clay stks, sand
651-681	sand
681-712	sand, clay stk
712-743	sand, clay bks
743-774	sand, cly bks, sandy clay
774-806	sandy clay, sand
806-837	sandy clay, clay
837-868	sandy clay, clay
868-899	clay, sandy clay
899-930	mostly clay
930-962	clay/sand stks, hard spot @ 940
962-993	clay/sand stks
993-1025	clay/sndy cly
1025-1056	sandy clay/sand
1056-1088	sand/brown clay streaks
1088-1119	sand/cly stks
1119-1151	sand
1151-1182	sand
1182-1212	sand, sandy clay
1212-1243	sand, sandy clay
1243-1275	sand, sandy cly stks
1275-1306	sand
1306-1337	sand
1337-1369	sand
1369-1399	sand/red clay

(TINSLEY)




FLORA QUADRANGLE
MISSISSIPPI
TOPOGRAPHIC SERIES (BERRYVILLE)

090° 20' 33.8289" W
032° 35' 27.4154" N

(BENTONIA)

090° 18' 13.3966" W
032° 35' 27.4154" N

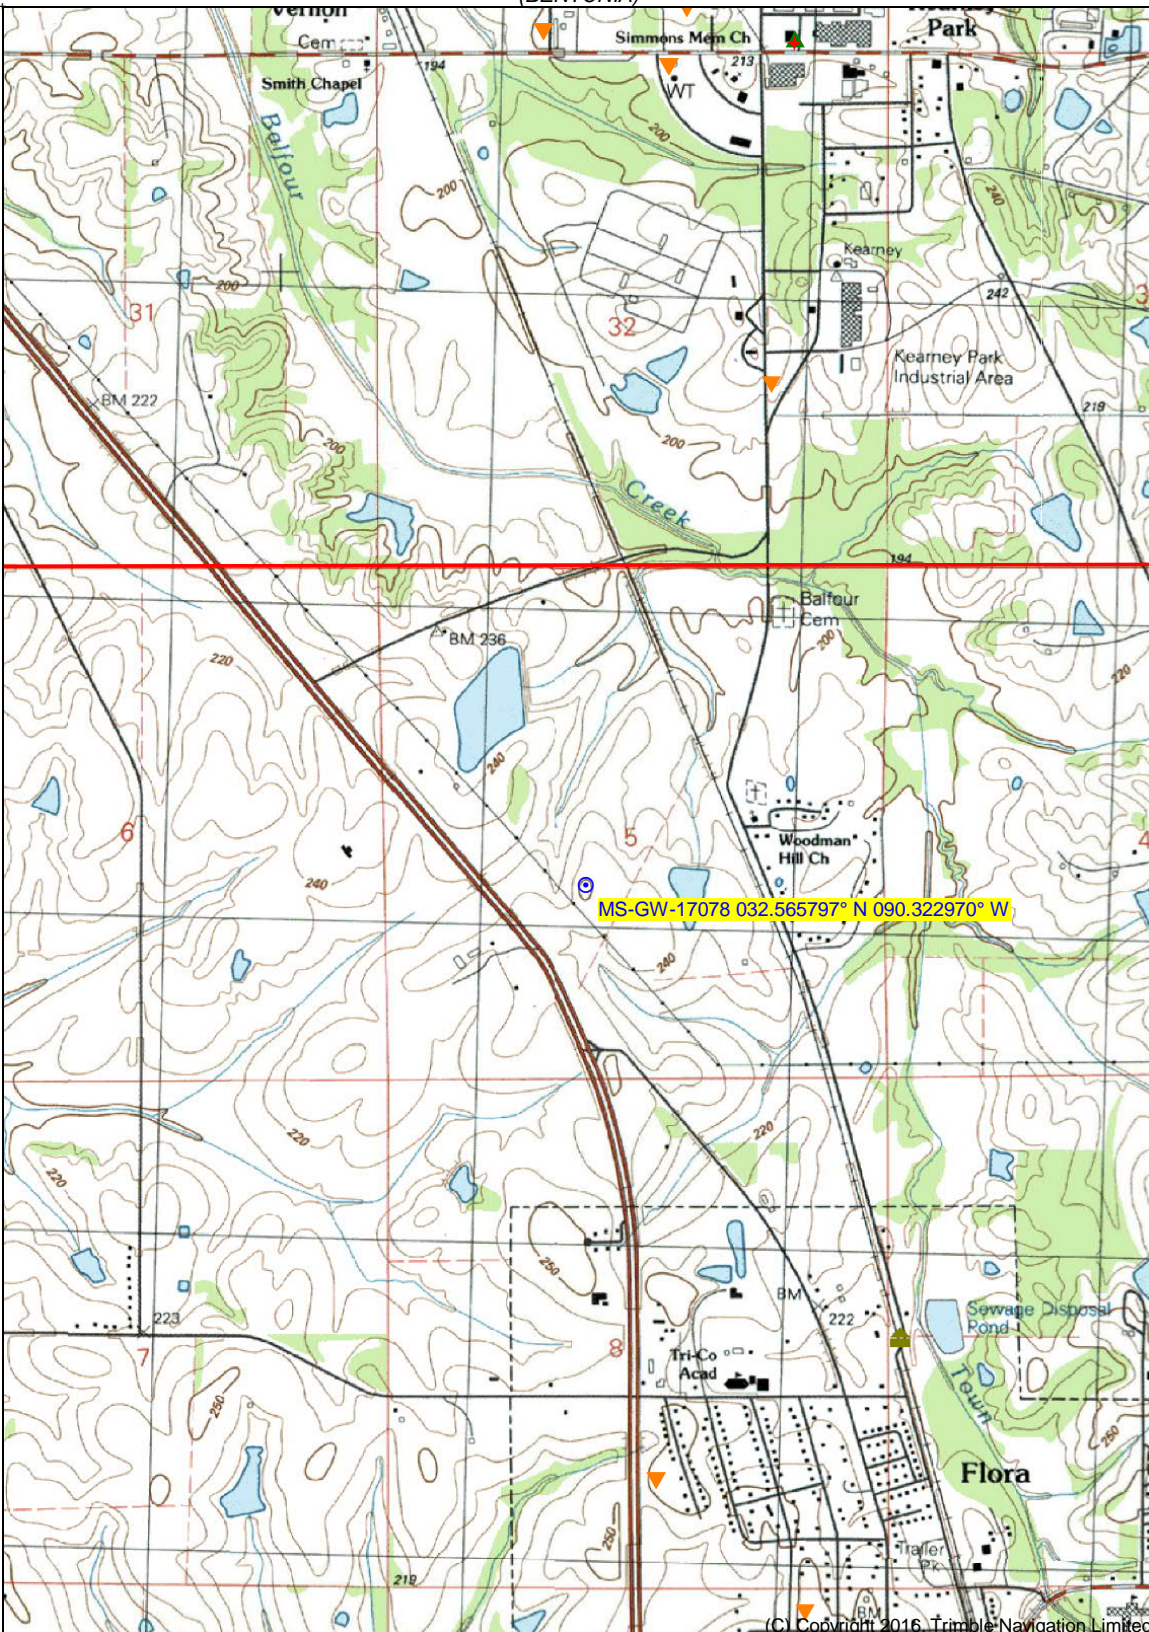

(COXS FERRY)

(CHARLTON)

MS-GW-17078 032.565797° N 090.322970° W

032° 32' 39.7799" N
090° 20' 33.8289" W

(POCAHONTAS)
SCALE 1:24000

Printed: Thu Apr 22, 2021
090° 18' 13.3966" W
032° 32' 39.7799" N

(BROWNSVILLE)


(RIDGELAND)

Produced by Trimble Terrain Navigator Pro
Topography based on USGS 1:24,000
Maps

North American 1983 Datum (NAD83)

To place on the predicted North American
1927 move the projection lines 16M N and
9M W

Declination

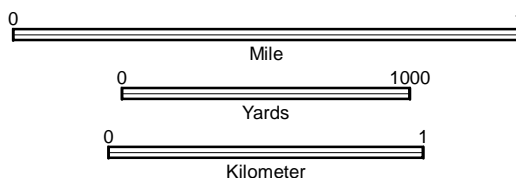

CONTOUR INTERVAL 10 FT

32090-E3-TM-024
FLORA, MS
JAN 1, 1988

(C) Copyright 2016, Trimble Navigation Limited