

MADISON
 R 2800
 2-25-79

MISSISSIPPI
 BOARD OF WATER COMMISSIONERS
 416 North State Street
 Jackson, Mississippi 39201

WATER WELL DRILLERS LOG

Feb. 25 1979 E.M. "Bud" Cresswell Madison
 date well completed firm name county well located

LANDOWNER: Mike EVANS
 FLORA, MS.
 (mailing address)

description of formations encountered	from to	
Clay	0	440
Dark. Red shells	440	470
Sandy shale	470	660
Sand	660	740

WELL LOCATION:
 sec 25 T 8 N R 1 W
 5 miles SE of FLORA
 (distance) (direction) (nearest town)

WELL PURPOSE: home
 (home, irrigation, municipal, industrial)

WELL COMPLETION DATA:

(1) diameter (inches) 4 x 2
 (2) total depth (feet) 740
 (3) static water level (feet) 180 below top of ground.
 (4) casing Steel, 720 (material), (depth)
 2 (size) if telescope see back.
 (5) screen 20, 720 (length), (depth to top)
 2, STAINLESS (size), (material)
 (6) pump 1 1/2, 20 (HP), (yield gpm)
 0 (type power)
 (7) electric log No (yes or no)
 (organization running log)

(8) how well bottom plugged
 Steel Plug
 DRILLERS REMARKS:


Miss. Board of Water Comm.

MAR 13 1979

RECEIVED

If well telescopes please sketch and show depths.

GROUND LEVEL

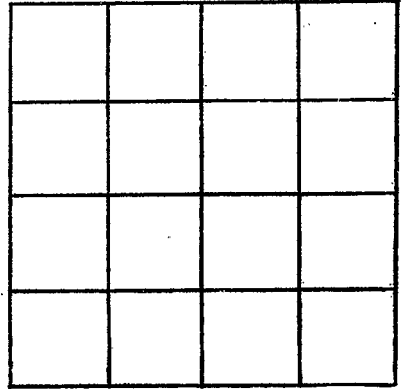

SECTION _____

Please indicate well location X.

ADDITIONAL INFORMATION

If more than one screen, show locations of each on sketch.