

**MISSISSIPPI DEPARTMENT OF NATURAL RESOURCES**  
**Bureau of Land and Water Resources**  
 Southport Mall  
 P.O. Box 10631  
 Jackson, Mississippi 39209  
**WATER WELL DRILLERS LOG**

Madison  
R 200

Aug. 27 1982 E.M. "Bud" CRESSWELL Madison  
 date well completed firm name county well located

LANDOWNER:	description of formations encountered	from	to
<u>Linda Brown</u> <u>Flora, Ms.</u> (mailing address)			
WELL LOCATION: sec <u>30</u> T. <u>20</u> N R. <u>10</u> W <u>3</u> miles <u>South</u> of <u>Flora</u> (distance) (direction) (nearest town)			
WELL PURPOSE: <u>Home</u> (home, irrigation, municipal, industrial)			
WELL COMPLETION DATA:			
(1) diameter (inches) <u>2</u>			
(2) total depth (feet) <u>95</u>			
(3) static water level (feet) <u>70</u> below top of ground.			
(4) casing <u>Pvc</u> <u>85</u> (material) (depth)			
<u>2</u> if telescope see back. (size)			
(5) screen <u>10</u> <u>85</u> (length) (depth to top)			
<u>2</u> <u>Pvc</u> (size) (material)			
(6) pump <u>1</u> <u>5</u> (HP) (yield gpm)			
<u>0</u> (type power)			
(7) electric log <u>No</u> (yes or no)			
<u></u> (organization running log)			
<u>0</u> how well bottom plugged <u>Part was valve</u>			
DRILLERS REMARKS:			


DEPT. OF NATURAL RESOURCES  
 BUREAU OF LAND & WATER RESOURCES

AUG 31 1982

**RECEIVED**

If well telescopes please sketch and show depths.

GROUND LEVEL

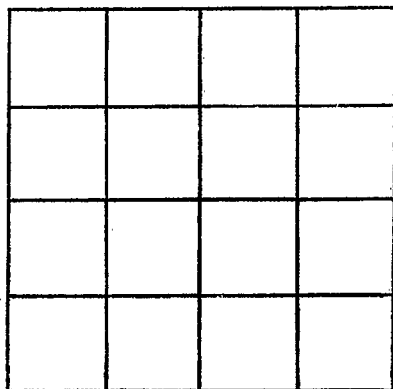

SECTION \_\_\_\_\_

Please indicate well location X.

ADDITIONAL INFORMATION

If more than one screen, show locations of each on sketch.