

Madison
R 2003

MISSISSIPPI
BOARD OF WATER COMMISSIONERS
416 North State Street
Jackson, Mississippi 39201

WATER WELL DRILLERS LOG

Nov. 16 1982 E.M. "Bud" Cresswell Madison
date well completed firm name county well located

LANDOWNER: Ellis Berry
FLORA, MS.
(mailing address)

description of formations encountered

from	to
0	90
90	110

WELL LOCATION:
sec 23 T 8 N R 1 E
4 miles SE of FLORA
(distance) (direction) (nearest town)

WELL PURPOSE: Home
(home, irrigation, municipal, industrial)

WELL COMPLETION DATA:

(1) diameter (inches) 2

(2) total depth (feet) 110

(3) static water level (feet) 80 below top of ground

(4) casing PVC 100
(material) (depth)

2 (size) if telescope see back.

(5) screen 10 100
(length) (depth to top)

2 PVC
(size) (material)

(6) pump 1 5
(HP) (yield gpm)

(type power) No

(7) electric log No
(yes or no)

(organization running log)

(8) How well bottom plugged:
Back Wash Valve

DRILLERS REMARKS:


DEPT. OF NATURAL RESOURCES
BUREAU OF LAND & WATER RESOURCES

NOV 22 1982

RECEIVED

If well telescopes please sketch and show depths.

GROUND LEVEL

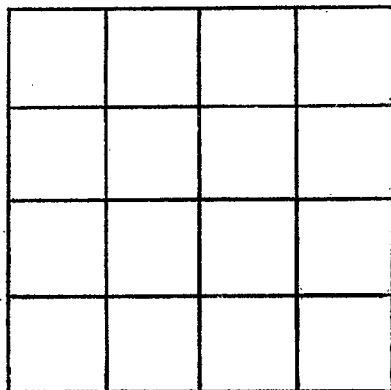

SECTION _____

Please indicate well location X.

ADDITIONAL INFORMATION

If more than one screen, show locations of each on sketch.