

MISSISSIPPI DEPARTMENT OF NATURAL RESOURCES

Bureau of Land and Water Resources

Southport Mall

P.O. Box 10631

Jackson, Mississippi 39209

WATER WELL DRILLERS LOG

MADISON

R 2004
MADISON
9-12-85

Sept. 12 1985
Date well completed

R.M. Bud Cresswell
firm name

Hinds
county well located

LANDOWNER:
Odis Jenkins

description of formations encountered

from

to

JACKSON, MS,
(mailing address)

Surface	0	30
blue clay	30	395
sand	395	420
shale	420	450
sand	450	595

WELL LOCATION:
sec. 36 T 8 N R 1 E
W
2 miles NO of JACKSON
(distance) (direction) (nearest town)

WELL PURPOSE: Home
(home, irrigation, municipal, industrial)

WELL COMPLETION DATA:

- (1) diameter (inches) 4
- (2) total depth (feet) 595
- (3) static water level (feet) 260 below top of ground.
- (4) casing PVC 565
(material) (depth)
4 if telescope see back.
(size)
- (5) screen 30 565
(length) (depth to top)
4 PVC
(size) (material)
- (6) pump 1 1/2 10
(HP) (yield gpm)
(type power)
- (7) electric log NO
(yes or no)
(organization running log)

(8) how well bottom plugged
Backwash valve

DRILLERS REMARKS:


RECEIVED

SEP 17 1985

Department of Natural Resources
Bureau of Land & Water Resources

If well telescopes please
sketch and show depths.

GROUND LEVEL

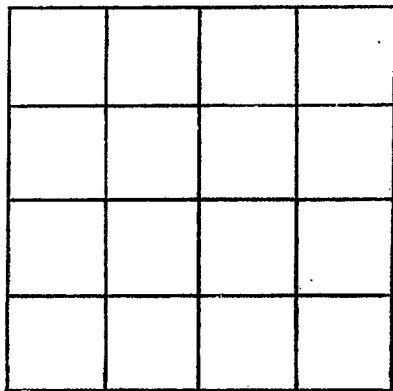

SECTION _____

Please indicate well location X.

ADDITIONAL INFORMATION

If more than one screen,
show locations of each on sketch.