

MADISON MISSISSIPPI BOARD OF WATER COMMISSIONERS

WATER WELL DRILLERS LOG

Date: 10-20-65, 1965, Driller: Forest Drilling County Madison
 (Name)


(1) Owner of Land: John Lott
 (Name)
Rt 1 Box 137 Rosa Mearns
 (Address)
 (2) Location: 1/4, 1/4, Sec. 31 T7 R2E,
8 miles NW of Madison
 (distance) (direction) (Nearest Town)
Mansfield Rd.
 (3) Topography: _____
 (Hilly) (Flat) (Level)
 (4) Purpose of Well: Home
 (Domestic Irrigation
 Municipal, Industrial, Other)

Description & Color of Materials Sand, Clay, Red Clay, Shell, etc.	Thick- ness Feet	Depth Feet
Brown Clay	0	8
Chalky Clay		35
Blue Clay		246
Blue Shale		369
Hard Shale + Shale Rock		428
Shale + Rock		435
Thin Shale + Sand		462
F. Sand + Lime		471
Lignite + Soft Clay		491
Hard Shale		512
Soft Shale		533
Shale		574
Shale + Shale Lignite		595
Shale		612
Silt + Shale		622
Silt Sand		637
Fine Sand		687

Information upon completion of well:

(1) Diameter 2 inches.
 (2) Total Depth 687 feet.
 (3) Water Level 208 feet below top of ground.
 (4) Cased to 677, Size 2"
 (5) Screen: Size 2", Length 15 ft.
 (6) Were any formations sealed against pollution?
 _____ yes, ✓ no.

If YES depth of formation _____
 Why _____
 Drillers Remarks: _____

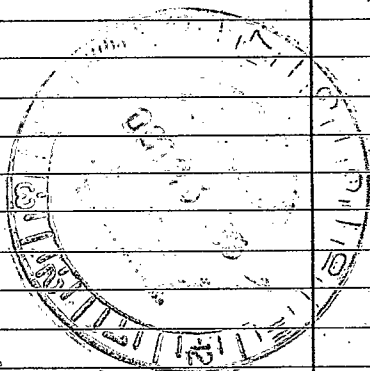

(Use Back Side)

Well No.

