

S  
4-2-64

WATER WELL DRILLERS LOG

14

Date: 4/2, 1964, Driller: MCKay County: Madison  
(Name)

(1) Owner of Land: Jama Green  
(Name)  
Flora Mae  
(Address)

(2) Location: 1/4, 1/4, Sec. T R R  
9 miles W of Madison  
(distance) (direction) (Nearest Town)

(3) Topography:  (Hilly)  (Flat)  (Level)

(4) Purpose of Well: Home  
(Domestic Irrigation  
Municipal, Industrial, Other)

Description & Color of Materials Sand, Clay, Red Clay, Shell, etc.	Thick- ness Feet	Depth Feet
<u>Yellow Clay</u>	<u>0</u>	<u>21</u>
<u>Blue clay</u>	<u>21</u>	<u>42</u>
<u>Blue clay</u>	<u>42</u>	<u>480</u>
<u>Fine, sandy clay</u>	<u>480</u>	<u>500</u>
<u>" " " "</u>	<u>500</u>	<u>520</u>
<u>" " " "</u>	<u>520</u>	<u>440</u>
<u>Sand-clay str</u>	<u>640</u>	<u>660</u>
<u>Med Sand</u>	<u>660</u>	<u>714</u>


Information upon completion of well:

- (1) Diameter 3 1/2 inches.
- (2) Total Depth 714 feet.
- (3) Water Level 169 feet below top of ground.
- (4) Cased to \_\_\_\_\_, Size \_\_\_\_\_
- (5) Screen: Size 007, Length 20
- (6) Were any formations sealed against pollution?  
\_\_\_\_\_ yes,  no.

If YES depth of formation \_\_\_\_\_

Why \_\_\_\_\_

Drillers Remarks: \_\_\_\_\_

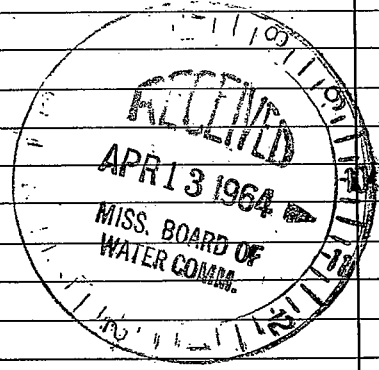

(Use Back Side)

Well No.

