




If well telescopes please sketch and show depths.

GROUND LEVEL

400' y 4"

746' y 2"

40' SCREEN

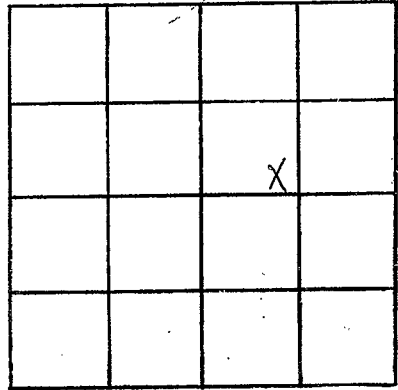

SECTION 19

Please indicate well location X.

ADDITIONAL INFORMATION

If more than one screen, show locations of each on sketch.