

MISSISSIPPI DEPARTMENT OF NATURAL RESOURCES

Bureau of Land and Water Resources

Southport Mall

P.O. Box 10631

CODED

Jackson, Mississippi 39209

WATER WELL DRILLERS LOG

S16
 MADISON Co.
 5-16-84

May 16 1984 Ed E.M. "Bud" Cresswell Madison
 date well completed firm name county well located

LANDOWNER:
Magnolia State Bird Dog Assn.
FLORA, MS.
 (mailing address)

description of formations encountered	from	to
	<u>Clay</u>	<u>0</u>
<u>Reddish Shale</u>	<u>460</u>	<u>580</u>
<u>Shale</u>	<u>580</u>	<u>670</u>
<u>Sand</u>	<u>670</u>	<u>760</u>

WELL LOCATION:
 sec. 7 T 8 N R 1 E
5 miles EAST of FLORA
 (distance) (direction) (nearest town)

WELL PURPOSE: Industrial
 (home, irrigation, municipal, industrial)

WELL COMPLETION DATA:
 (1) diameter (inches) 4
 (2) total depth (feet) 760
 (3) static water level (feet) 170 below top of ground.
 (4) casing PVC 720
 (material) (depth)
4 if telescope see back.
 (size)
 (5) screen 40 720
 (length) (depth to top)
2 PVC
 (size) (material)
 (6) pump 1 1/2 15
 (HP) (yield gpm)
 (type power)
 (7) electric log no
 (yes or no)
 (organization running log)

(8) How well bottom plugged back wash valve


DRILLERS REMARKS:

DEPT. OF NATURAL RESOURCES
 BUREAU OF LAND & WATER RESOURCES

MAY 24 1984
 RECEIVED

If well telescopes please sketch and show depths.

GROUND LEVEL

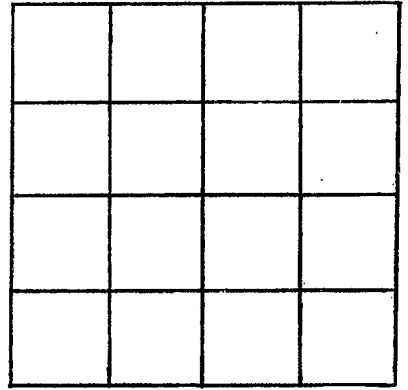

SECTION _____

Please indicate well location X.

ADDITIONAL INFORMATION

If more than one screen,
show locations of each on sketch.