

MISSISSIPPI DEPARTMENT OF NATURAL RESOURCES

Bureau of Land and Water Resources

Southport Mall

P.O. Box 10631

Jackson, Mississippi 39209

WATER WELL DRILLERS LOG

MADISON
S18
2-5-88

SERI

CODED

Feb. 5 1988 E.M. Bud Cresswell MADISON
date well completed firm name county well located

LANDOWNER:	description of formations encountered	from	to
Charles Williams Madison, Ms. (mailing address)			
	Yazoo clay	30	400
	Madison Sand	400	430
	Blue, ch. - sh. sand	430	750
	Tough, ch. - sh. sand	750	950
	Sand	950	1080
WELL LOCATION:			
sec. 31 T 8 N R 1 E 3 miles west of Madison (distance) (direction) (nearest town)			
WELL PURPOSE: Home (home, irrigation, municipal, industrial)			
WELL COMPLETION DATA:			
(1) diameter (inches) 4			
(2) total depth (feet) 1060			
(3) static water level (feet) 200 below top of ground.			
(4) casing Steel 1020 (material) (depth) 4 (size) if telescope see back.			
(5) screen 40 1020 (length) (depth to top) 2 Stainless (size) (material)			
(6) pump 2 25 (HP) (yield gpm) 0 (type power)			
(7) electric log yes (yes or no) State (organization running log)			
(8) how well bottom plugged Sack Wash -			
DRILLERS REMARKS:			


CODED

RECEIVED
FEB 10 1988

Department of Natural Resources
Bureau of Land & Water Resources

If well telescopes please sketch and show depths.

GROUND LEVEL

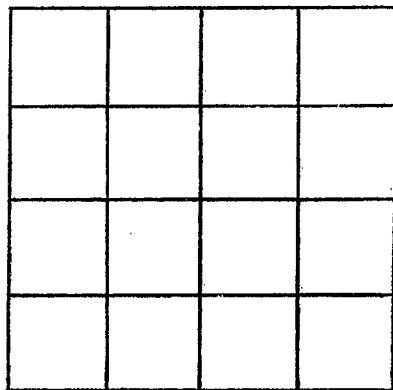

SECTION _____

Please indicate well location X.

ADDITIONAL INFORMATION

If more than one screen,
show locations of each on sketch.