

**MISSISSIPPI DEPARTMENT OF NATURAL RESOURCES**  
**Bureau of Land and Water Resources**  
 Southport Mall  
 P.O. Box 10631  
 Jackson, Mississippi 39209  
**WATER WELL DRILLERS LOG**

Madison  
519  
7-28-88

*Coked*

7-28 1988 STEVE GARDNER WATER WELLS MADISON  
 date well completed firm name county well located

LANDOWNER: <u>HAROLD WALDROP</u>	description of formations encountered	from	to
<u>MADISON</u>			
	<u>CLAY</u>	<u>0</u>	<u>320</u>
(mailing address)	<u>CLAY, SHELL, SAND</u>	<u>320</u>	<u>340</u>
WELL LOCATION:	<u>SHELL, SAND</u>	<u>340</u>	<u>420</u>
sec. <u>21</u> T <u>8</u> N R <u>1</u> W	<u>SHELL, SAND, LIGNITE</u>	<u>420</u>	<u>480</u>
<u>8</u> miles <u>C-SE4</u> of <u>MADISON</u>	<u>SAND</u>	<u>480</u>	<u>640</u>
(distance) (direction) (nearest town)	<u>CLAY</u>	<u>640</u>	<u>660</u>
WELL PURPOSE: (home, irrigation, municipal, industrial)	<u>SAND</u>	<u>660</u>	<u>670</u>
WELL COMPLETION DATA:	<u>SAND</u>	<u>670</u>	<u>720</u>
(1) diameter (inches) <u>4</u>	<u>CLAY</u>	<u>720</u>	<u>731</u>
(2) total depth (feet) <u>731</u>			
(3) static water level (feet) <u>181</u> below above top of ground.			
(4) casing <u>PVC</u> <u>550</u> (material) (depth)			
<u>        </u> if telescope see back. (size)			
(5) screen <u>90</u> <u>640</u> (length) (depth to top)			
<u>4"</u> <u>PVC</u> (size) (material)			
(6) pump <u>5</u> <u>50</u> (HP) (yield gpm)			
<u>A.C.</u> (type power)			
(7) electric log <u>YSS</u> (yes or no)			
<u>Misc BUREAU - GEOLOGY</u> (organization running log)			
(8) how well bottom plugged <u>BACK</u> <u>WASH VAL</u>			
DRILLERS REMARKS:			

**RECEIVED**  
 MAR 03 1989

Department of Natural Resources  
 Bureau of Land & Water Resources

If well telescopes please sketch and show depths.

GROUND LEVEL

550


~ ~

~ ~

~ ~

~ ~

640

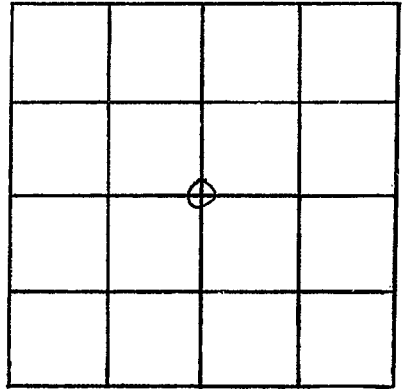

SECTION 21

Please indicate well location X.

ADDITIONAL INFORMATION

If more than one screen,  
show locations of each on sketch.