

MISSISSIPPI DEPARTMENT OF NATURAL RESOURCES
Bureau of Land and Water Resources
 Southport Mall
 P.O. Box 10631
 Jackson, Mississippi 39209
WATER WELL DRILLERS LOG

MADISON
S 20
8-20-88

Coded

8 20 1988 STEVES CAROLINA WATER WELLS MADISON
 date well completed firm name county well located

LANDOWNER: DUDLEY J. HUGHES
MADISON
 (mailing address)

WELL LOCATION:
 sec. 21 T. 8 N S R. 1 E W
8 miles of MADISON
 (distance) (direction) (nearest town)

description of formations encountered	from	to
<u>CLAY</u>	<u>0</u>	<u>390</u>
<u>SAND, SHELL, CLAY</u>	<u>390</u>	<u>520</u>
<u>SAND</u>	<u>520</u>	<u>660</u>
<u>SAND, CLAY</u>	<u>660</u>	<u>686</u>

WELL PURPOSE:
 (home, irrigation, municipal, industrial)

WELL COMPLETION DATA:

(1) diameter (inches) 4"

(2) total depth (feet) 686

(3) static water level (feet) 199 below above top of ground.

(4) casing PVC, 520
 (material) (depth)

 (size) if telescope see back.

(5) screen 4", 590
 (length) (depth to top)

4", P.V.C.
 (size) (material)

(6) pump 5, 50
 (HP) (yield gpm)

A C
 (type power)

(7) electric log YES
 (yes or no)

MISS-BUREAU GEOLOGY
 (organization running log)

(8) how well bottom plugged BACK
WASH VAL

RECEIVED

MAR 03 1988

Department of Natural Resources
 Bureau of Land & Water Resources

DRILLERS REMARKS:

If well telescopes please sketch and show depths.


GROUND LEVEL

520

~ ~ ~
~ ~ ~
590

If more than one screen,
show locations of each on sketch.

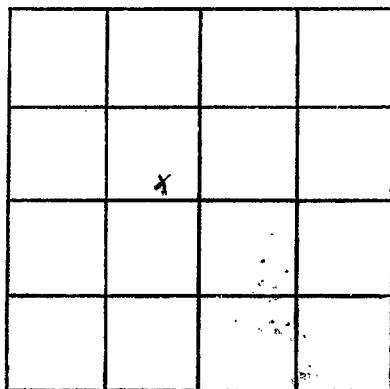

SECTION 21

Please indicate well location X.

ADDITIONAL INFORMATION

Lined area for additional information.