

MISSISSIPPI DEPARTMENT OF NATURAL RESOURCES

Bureau of Land and Water Resources

Southport Mall

P.O. Box 10631

Jackson, Mississippi 39209

WATER WELL DRILLERS LOG

MADISON
524
GW-12367

Cordell

Jan 15 1991 Laure-Central Co. Madison
date well completed firm name county well located

LANDOWNER: Lake Caroline, Inc.
Well Site #2 - South Well
P.O. Box 1214

Madison, MS 39110
(mailing address)

WELL LOCATION: Center of Section
sec. 12 T. 8 N. R. 1 E
S. W.


(distance) miles (direction) of (nearest town)

WELL PURPOSE: Municipal
(home, irrigation, municipal, industrial)

WELL COMPLETION DATA:

- (1) diameter (inches) 12"
- (2) total depth (feet) 1126'
- (3) static water level (feet) 220' below above top of ground.
- (4) casing Steel, 1060'
(material) (depth)
12" If telescope see back.
(size) 4 1/2" of 8"
- (5) screen 56', 1060'
(length) (depth to top)
8", Stainless Steel
(size) (material)
- (6) pump 30 200
(HP) (yield gpm)
460 volts
(type power)
- (7) electric log Yes
(yes or no)
Laure-Central Co.
(organization running log)
- (8) how well bottom plugged 4 1/2" Back
Pressure Valve

description of formations encountered	from	to
Yellow Clay	0	35'
Blue Clay	35'	295'
Sandy Clay	295'	320'
Shale	320'	407'
Sandy Clay	407'	475'
Sandy Clay	475'	590'
Hard Clay	590'	836'
Sandy Clay & Hard Shale	836'	1091'
Sand	1091'	1133'
Hard Shale	1133'	1216'

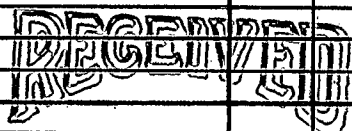


MAY 31 1991

Dept. of Environmental Quality
Bureau of Land & Water Resources

DRILLERS REMARKS: Permit #
MS-GW-12962

If well telescopes please sketch and show depths.

GROUND LEVEL

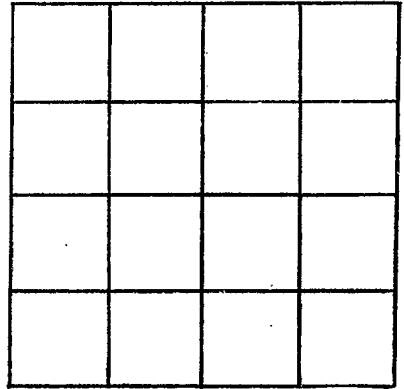

SECTION _____

Please indicate well location X.

ADDITIONAL INFORMATION

If more than one screen,
show locations of each on sketch.