

MISSISSIPPI DEPARTMENT OF ENVIRONMENTAL QUALITY

Office of Land and Water Resources

P. O. Box 10631
Jackson, MS 39289-0631
WATER WELL DRILLERS LOG

COUNTY WELL LOCATED Madison	
WELL NUMBER 6-4 #1	CODED <input checked="" type="checkbox"/>
528	
DATE WELL COMPLETED 11-24-92	

089

PERMIT NUMBER 0-402
NAME OF DRILLING FIRM Tom Griffin
Water Well

NAME & MAILING ADDRESS OF LANDOWNER MURCO Drilling CO			
100 TRAVIS, Suite 100			
SHREVEPORT, LA 71108-3188			
WELL LOCATION: SEC	TOWNSHIP	RANGE	
6	8	N S	1 W
DISTANCE	DIRECTION	NEAREST TOWN	
3 Miles	E	FLORA	
OTHER LANDMARK			
WELL PURPOSE: Home, Irrigation, Municipal, Industrial, Fish Pond, etc. Rig supply			

PUMP DATA		
PUMP TYPE (Circle One): Submersible, Turbine, Jet, Flowing Well, Other (Describe) _____		
POWER TYPE (Circle One): Electric, Tractor, Diesel, Gasoline, Butane, Other (Describe) _____ H/P _____		
Pump Capacity (GPM)	No. of Stages	Setting Depth
		FT.
PUMP TEST Air Lift		
Well yielded 80 GPM with a drawdown of _____ ft. after _____ hours of pumping		

Well Depth 530	Casing Diameter (in.) 4	Casing Length (Ft.) 500
Type of Casing PVC	Hole Depth 530	Depth to Static Water Level
TYPE OF COMPLETION: (Circle One or More): Gravel Packed, Underreamed, Telescoped, <u>Natural Development</u> , Open Hole, Other		
WELL GROUTED TO A DEPTH OF 10 FEET Type Grout (circle one): <u>Cement</u> , Bentonite, or Mix		

LOG DATA	
TYPE OF LOG RUN (Circle One): No Log Run, Electric, Gamma Ray, Density, Sonic, Neutron, Other (Describe) _____	
Name of Organization Running Log	

SCREEN DATA		
Diameter - Inches 4	Length - Feet 30	Slot Size - Inches .025
Screen Type PVC	Depth to Bottom - Feet 0	


GEOLOGIC DATA (Office Use Only)			
Surface Elev.	Geologic Unit	Unit Thickness	Depth to Top
Subs. SWL	Date	Analysis	Aquifer Test
Driller's Remarks			

DESCRIPTION OF FORMATIONS ENCOUNTERED	FROM	TO
White Clay	1	45
Blue Clay	45	245
Rock	245	246
Sandy Clay	246	500
Sand	500	530

FORMATIONS (Continued)	FROM	TO
RECEIVED		
JUL 02 1993		
Dept. of Environmental Quality Office of Land & Water Resources		
IF MORE SPACE IS NEEDED, USE BACK		

If well telescopes please
sketch and show depths.

GROUND LEVEL

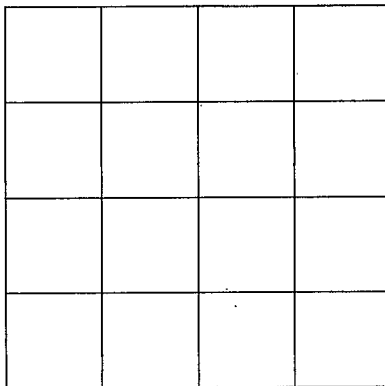

SECTION _____

Please indicate well location X.

ADDITIONAL INFORMATION

If more than one screen,
show location of each on sketch.