

County: Madison
 Permit #: _____
 Driller: Hester Blissard
 Date drilling completed: 7-3-02

State Well Report
Part I - Driller's Log
 Mississippi Department of Environmental Quality
 Office of Land and Water Resources
 P.O. Box 10691
 Jackson, MS 39289-0691
 (601)961-5210
 (601)354-6938 (fax)

For Office Use Only:
 Aquifer: _____
 Well #: 5-40
 L.S. Elevation: _____
 E-log #: _____

State Law requires that this report be prepared by the license holder responsible for the work and filed with the Department at the above address within 30 days of completion of drilling of the well or borehole.

<p>Information on Well Owner (Landowner if borehole is not for a water well)</p> <p>Owner Name: <u>CAHAN</u> Mailing Address: <u>Lot R-5 Reunion</u> <u>Sub Division</u> <u>Madison Ms 39110</u> City State Zip Code Telephone No. <u>(601) 262-8463</u> <u>Kevin Key (Contractor) Hermetic Rush</u></p>	<p>Well or Borehole Location</p> <p>Latitude: <u>32° 30' 41.7"</u> Longitude: <u>90° 9' 46.9"</u> <u>42</u> <u>47</u> Method of Lat/Long (circle one): <u>Conventional Survey</u> USGS quad, Hand-held GPS, Survey-grade GPS <u>SW 1/4 NE 1/4 Sec 26 Twa 8N Rng 1E</u> Distance Direction Nearest Town <u>1.5 Miles West of Annapolis, MS</u> <u>East</u></p>
--	---

Well / Borehole Data

Date drilling started: 6-30-02 Date drilling completed: 7-3-02 Hole depth: 250 ft Hole diameter: 4 3/4

Location of the source of any surface water used for drilling: _____
 Method of flooding and volume of Chlorine used in drilling and development: _____

Logs run (circle all applicable): No log run Electric Gamma Ray Density Sonic Neutron Other: _____
 Name of organization running logs: _____

Purpose of borehole (check one): Water Well _____ Geomorphological/Geological Investigation _____ Ground Source Heat Pump
 Seismic Survey _____ Other (describe) _____
 If drilling is not related to water well construction, skip the remainder of this block

Purpose of Well (check one): Home _____ Industrial _____ Public Supply _____ Irrigation _____ Fish Culture _____ Other: _____

If a flowing well, method of flow regulation: Valve _____ Other (describe) _____

Static Water Level: _____ feet above or below (circle one) land surface Date measured: _____

Method of Measurement (circle one) steel tape electric tape air line other: _____

Well depth: _____ Well grouted to a depth of _____ feet Type of grout (circle one): Neat Cement Bentonite Mix
 Casing length: _____ feet Casing diameter: _____ inches Type of casing: _____
 Screen length: _____ feet Screen diameter: _____ inches Type of screen: _____
 Screen slot size: _____ inches Setting depth: From _____ feet to _____ feet

Type of completion (circle all applicable): Gravel packed Underreamed Telescoped Open hole Natural Development
 Other (describe): _____

Top of lap pipe or reduction in casing: _____ feet If telescoped or wire line screen, describe on next page

Form OLWR-SWR-1A


RECEIVED
 JUL 18 2008
 BY: OLWR

5-40

The sketch below only required for water wells.

If well telescopes, show depths on sketch.

Ground Level

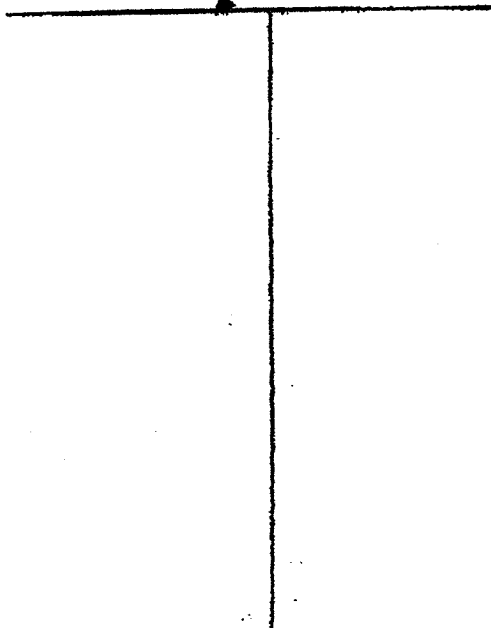

Description of Formations encountered must be provided for all wells and boreholes, unless specifically exempted by regulations.

Description of Formations Encountered	From (depth)	To (depth)
	Ground Level	
Red Clay	0 -	20 FT
Tan Clay	20 FT	45 FT
Grey Clay	45 FT	250 FT

If more than one screen, show location of each on sketch.

Sketch the property layout and include the following: 1) the well location; 2) any permanent structures on the property that may aid in locating the well; 3) any roads, power lines, or other items that may aid in locating the property and the well; 4) a north arrow.

Landowner Name: _____

Form: OLWR-SWR-1A

I certify that the well/borehole was drilled, constructed, and completed in accordance with all applicable requirements of the Mississippi Department of Environmental Quality and the Mississippi Department of Health regulations, if applicable, and state laws.

Fred Danforth 0-69867 7-15-08

Fred Danforth

Print Name of Responsible Licensee and License No.

Date

Signature of Licensee


RECEIVED
JUL 18 2008
BY: OLWR

10 Holes

Madison Reunion Job

5-40

GPS X
N 32° 30' 41.7"
W 90° 9' 46.9"

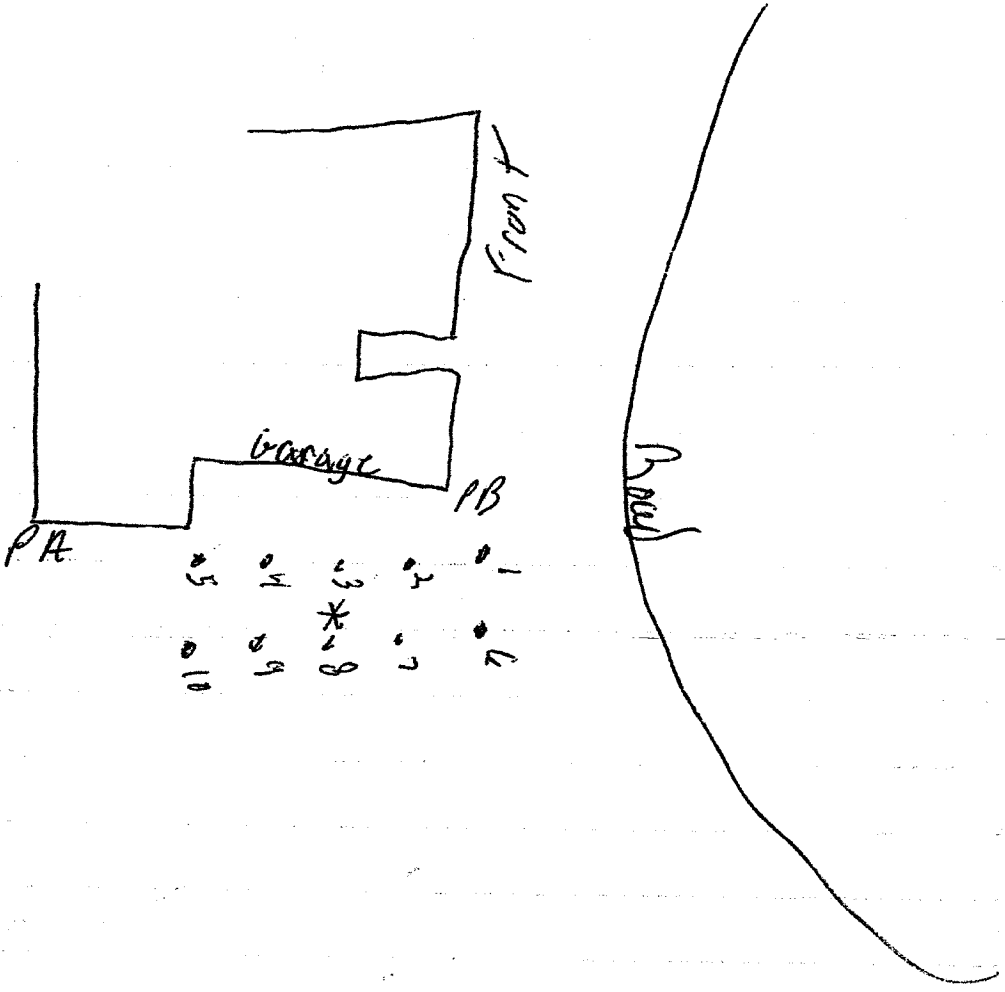

PA	PB
1 112	1 15 16
2 93	2 31 15
3 74	3 30 31
4 54	4 24 50
5 38	5 64
6 116	6 35
7 106	7 20
8 84	8 35
9 71	9 49
10 56	10 67

Nearest town How far
Annandale, MS
1.5 miles ~~East~~ West
of this location But we
r East of the town

Note
if tom tom
says west of U
r east of it
b/c you have
to go west to
get there + to
U would have to
go east from there
to get here

RECEIVED
JUL 18 2008
BY: OLWR