

MADISON MISSISSIPPI BOARD OF WATER COMMISSIONERS

T

5-16-64

WATER WELL DRILLERS LOG

Date: 5/16, 1964, Driller: M. E. Ray County Madison
(Name)

(1) Owner of Land: Louis Clark
(Name)
Madison, Miss.
(Address)

(2) Location: 1/4, 1/4, Sec. T. R.
7 miles NE of MADISON
(distance) (direction) (Nearest Town)

(3) Topography: (Hilly) (Flat) (Level)

(4) Purpose of Well: Home-Dwelling
(Domestic Irrigation, Municipal, Industrial, Other)

Description & Color of Materials Sand, Clay, Red Clay, Shell, etc.	Thick- ness Feet	Depth Feet
White clay	0	20
Blue " "	20	40
" " "	40	280
Muddy Brown	280	340
Brown Sand clay	340	380
" " "	380	420
Sandy clay	420	500
Fine Sand	500	520
Med to Fine Sand Lignite	520	540
" " "	540	560
" " "	560	630
Brown clay	630	650
" " Sand	650	760
Rock - Shale	760	760
Clay - Sand Str.	760	800
Fine Sand	800	820
Fine Sand	820	860
Sand - Lignite	860	890
" " "	890	910
30 - med Sand (bet seen)	910	930
Shale	930	950

Information upon completion of well:

(1) Diameter: 4 x 2 1/2 x 2 inches.

(2) Total Depth: 950 feet.

(3) Water Level: 108 feet below top of ground.

(4) Cased to 504, Size 4"
30ft 2 1/2 - 525 - 555 - 20 ft 4" 910 - 930


(5) Screen: Size 2 1/2 - 2, Length 30 - 2 1/2
20 - 2

(6) Were any formations sealed against pollution?
 _____ yes, no.

If YES depth of formation _____

Why _____

Drillers Remarks: _____

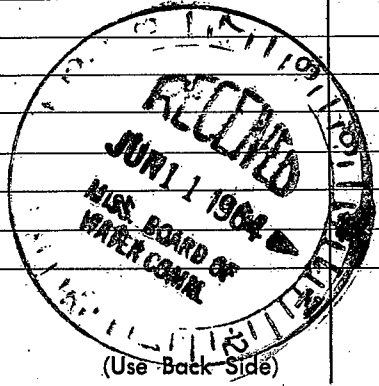

Well No. _____

